


95.21532 38.97792 140

1. Location of well:	County Douglas	Fraction NE SW NE 1/4 SW 1/4 NE 1/4	Section number 29	Township number T 12	Range number S R 20	EW
----------------------	--------------------------	---	-----------------------------	--------------------------------	-------------------------------	-----------

2. Distance and direction from nearest town or city: Street address of well location if in city: 9th + Maple, Lawrence	3. Owner of well: FMC Corp R.R. or street: 9th + Maple City, state, zip code: Lawrence, Kansas 66044
--	---

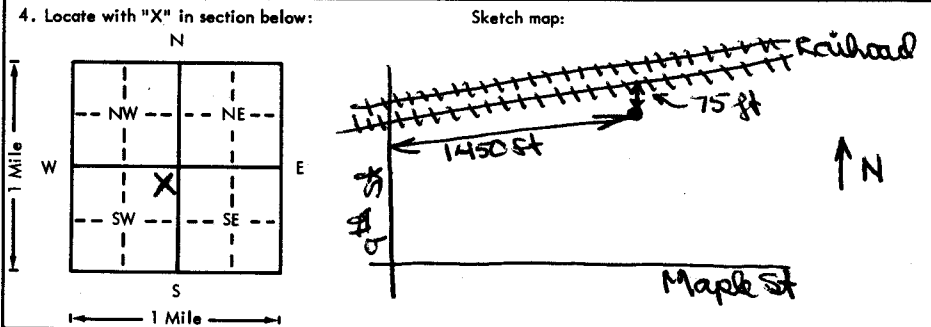

6. Bore hole dia. 3 in. Completion date _____ Well depth 47 ft. 12/22/75
7. <input checked="" type="checkbox"/> Cable tool <input type="checkbox"/> Rotary <input type="checkbox"/> Driven <input type="checkbox"/> Dug <input type="checkbox"/> Hollow rod <input type="checkbox"/> Jetted <input type="checkbox"/> Bored <input type="checkbox"/> Reverse rotary
8. Use: <input type="checkbox"/> Domestic <input type="checkbox"/> Public supply <input type="checkbox"/> Industry <input type="checkbox"/> Irrigation <input type="checkbox"/> Air conditioning <input type="checkbox"/> Stock <input type="checkbox"/> Lawn <input type="checkbox"/> Oil field water <input checked="" type="checkbox"/> Other
9. Casing: Material Steel Height: Above or below Threaded _____ Welded <input checked="" type="checkbox"/> Surface 1.374 in. RMP _____ PVC _____ Weight _____ lbs./ft. Dia. 4 in. to 42 ft. depth Wall Thickness: inches or Dia. _____ in. to _____ ft. depth gage No. 0.25 in

5. Type and color of material	From	To
SILT - yellow brown	0	5
CLAY - yellow brown	5	7
SILTY SAND - yellow brown	7	14
CLAY - yellow brown	14	15.5
SAND - fine, yellow brown	15.5	19.5
SILTY SAND - fine, yellow brown	19.5	23
SAND - medium, red brown	23	25
SILTY SAND - fine, gray	25	26
SAND - fine, gray	26	27
SILTY SAND - fine, gray	27	28.5
SAND - medium, gray	28.5	45
SANDY CLAY - gray	45	46.5
SAND - medium, gray	46.5	49
SAND - medium to coarse, gray	49	50.5
BEDROCK	50.5	

10. Screen: Manufacturer's name Johnson Type low carbon steel Dia. 4 in Slot/gauge 30 Length 3 ft Set between 42 ft. and 45 ft. ft. and _____ ft. Gravel pack? NO Size range of material _____
11. Static water level: _____ mo./day/yr. 20 ft. below land surface Date 12/22/75
12. Pumping level below land surfaces: NA _____ ft. after _____ hrs. pumping _____ g.p.m. _____ ft. after _____ hrs. pumping _____ g.p.m. Estimated maximum yield _____ g.p.m.
13. Water sample submitted: _____ mo./day/yr. Yes <input checked="" type="checkbox"/> No <input type="checkbox"/> Date _____
14. Well head completion: NA <input type="checkbox"/> Pitless adapter 12" x Inches above grade
15. Well grouted? YES With: <input checked="" type="checkbox"/> Neat cement <input type="checkbox"/> Bentonite <input type="checkbox"/> Concrete Depth: From 0 ft. to 14 ft.
16. Nearest source of possible contamination: NA ft. _____ Direction _____ Type _____ Well disinfected upon completion? _____ Yes <input checked="" type="checkbox"/> No <input type="checkbox"/>
17. Pump: <input checked="" type="checkbox"/> Not installed Manufacturer's name _____ Model number _____ HP _____ Volts _____ Length of drop pipe _____ ft. capacity _____ g.p.m. Type: <input type="checkbox"/> Submersible <input type="checkbox"/> Turbine <input type="checkbox"/> Jet <input type="checkbox"/> Reciprocating <input type="checkbox"/> Centrifugal <input type="checkbox"/> Other

18. Elevation:	19. Remarks:
Topography: <input type="checkbox"/> Hill <input type="checkbox"/> Slope <input type="checkbox"/> Upland <input checked="" type="checkbox"/> Valley	

20. Water well contractor's certification: This well was drilled under my jurisdiction and this report is true to the best of my knowledge and belief. JUNIOR BROS 119A Business name License No. Address CAABONDPALE Signed John [Signature] Date 12-22-75 Authorized representative
--

1220029
NE 1/4 SW 1/4