PRINT CLEARLY.

WATER WELL RECORD
KSA 82a-1201-1215

Kansas Department of Health and Environment-Division of Environment
(Water well Contractors)
Topeka, Kansas 66620

95.21651 38.97974

166

1. Location of well:	County	Fraction	Section number	Township number	Range number
	DOUGLAS	SE 1/4 NW 1/4 SE 1/4	29	T 12 S	R 20 E/W

2. Distance and direction from nearest town or city:

Street address of well location if in city:

3. Owner of well: FMC
R.R. or street: 9TH MAPLE
City, state, zip code: LAWRENCE KS

4. Locate with "X" in section below:

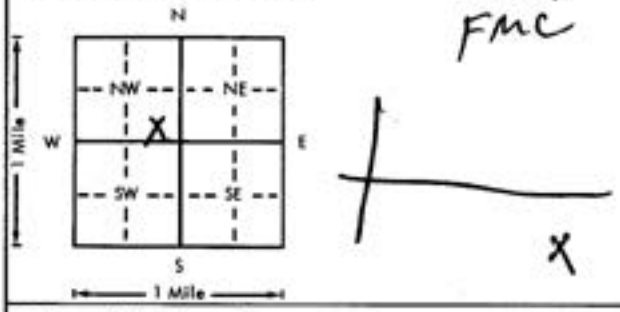

Sketch map:

FMC

6. Bore hole dia. 8 in. Completion date 2-76
Well depth 34 ft.

7. X Cable tool __ Rotary __ Driven __ Dug
__ Hollow rod __ Jetted __ Bored __ Reverse rotary

8. Use: __ Domestic __ Public supply __ Industry
__ Irrigation __ Air conditioning __ Stock
__ Lawn __ Oil field water X Other

9. Casing: Material STEEL Height: Above or below
Threaded __ Welded X Surface 12 11+ in.
RMP __ PVC __ Weight __ lbs./ft.
Dia. __ in. to __ ft. depth Wall Thickness: inches or
Dia. 4 in. to 31 ft. depth gage No. .25

5. Type and color of material	From	To
SOIL	0	2
CLAY BROWN	2	11
FINE SAND DRY	11	20
MEDIUM BLUE	27	38
COARSE DIRTY BLUE	38	45
(Use a second sheet if needed)		

10. Screen: Manufacturer's name JOHNSON
Type STAINLESS STEEL Dia. 4
Slot/gauze 30 Length 3
Set between 31 ft. and 34 ft.
__ ft. and __ ft.
Gravel pack? NO Size range of material

11. Static water level: mo./day/yr.
17 ft. below land surface Date 2-11-76

12. Pumping level below land surface:
__ ft. after __ hrs. pumping __ g.p.m.
__ ft. after __ hrs. pumping __ g.p.m.
Estimated maximum yield __ g.p.m.

13. Water sample submitted: mo./day/yr.
__ Yes X No Date

14. Well head completion:
__ Pitless adapter __ Inches above grade

15. Well grouted? X
With: X Neat cement __ Bentonite __ Concrete
Depth: From 0 ft. to 15 ft.

16. Nearest source of possible contamination:
ft. __ Direction __ Type __
Well disinfected upon completion? __ Yes X No

17. Pump: __ Not Installed
Manufacturer's name __
Model number __ HP __ Volts __
Length of drop pipe __ ft. capacity __ g.p.m.
Type:
__ Submersible __ Turbine
__ Jet __ Reciprocating
__ Centrifugal __ Other

18. Elevation:

Topography:
__ Hill
__ Slope
__ Upland
X Valley

19. Remarks:

20. Water well contractor's certification:
This well was drilled under my jurisdiction and this report is true to the best of my knowledge and belief.
Layne Bros 119A
Business name License No.
Address GARDNERVILLE NV
Signed [signature] Date 2-76
Authorized representative

1/4 T 12 R 20 E/W Sec 29 1/4 1/4 SE NW

Forward the white, blue and pink copies to the Department of Health and Environment

Form WWC-5