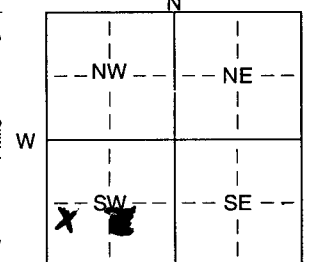


LOCATION OF WATER WELL: Fraction NW 1/4 SW 1/4 Section Number 2 Township Number T 12 S Range Number R 20 E
 County: Leavenworth

Distance and direction from nearest town or city street address of well if located within city?
24900 Chieftain Rd. Lawrence, KS 66044

WATER WELL OWNER: David Eichler
 RR#, St. Address, Box #: 1935 Ohio St. Board of Agriculture, Division of Water Resources
 City, State, ZIP Code: Lawrence, KS. 66044 Application Number:

LOCATE WELL'S LOCATION WITH AN "X" IN SECTION BOX:

 DEPTH OF COMPLETED WELL: 318 ft. ELEVATION:
 Depth(s) Groundwater Encountered 1. 238-314 ft. 2. ft. 3. ft.
 WELL'S STATIC WATER LEVEL 212 ft. below land surface measured on mo/day/yr 6-27-01
 Pump test data: Well water was ft. after hours pumping gpm
 Est. Yield 25 gpm: Well water was ft. after hours pumping gpm
 Bore Hole Diameter: 8.314 in. to 3.18 ft., and in. to ft.
 WELL WATER TO BE USED AS:
 1 Domestic 3 Feedlot 6 Oil field water supply 9 Dewatering 12 Other (Specify below)
 2 Irrigation 4 Industrial 7 Domestic (lawn & garden) 10 Monitoring well
 Was a chemical/bacteriological sample submitted to Department? Yes. No ; If yes, mo/day/yr sample was submitted
 Water Well Disinfected? Yes No

TYPE OF BLANK CASING USED:
 1 Steel 3 RMP (SR) 6 Asbestos-Cement 9 Other (specify below) Welded
 2 PVC 4 ABS 7 Fiberglass Threaded
 CASING JOINTS: Glued Clamped
 Blank casing diameter 5 in. to 3.08 ft., Dia in. to ft., Dia in. to ft.
 Casing height above land surface: 30 in., weight 50R. 21 lbs./ft. Wall thickness or gauge No.

TYPE OF SCREEN OR PERFORATION MATERIAL:
 1 Steel 3 Stainless steel 5 Fiberglass 8 RMP (SR) 10 Asbestos-cement
 2 Brass 4 Galvanized steel 6 Concrete tile 9 ABS 11 Other (specify)
 12 None used (open hole)
 SCREEN OR PERFORATION OPENINGS ARE:
 1 Continuous slot 3 Mill slot 2500
 2 Louvered shutter 4 Key punched 7 Torch cut 8 Saw cut 11 None (open hole)
 6 Wire wrapped 9 Drilled holes

SCREEN-PERFORATED INTERVALS: From 308 ft. to 318 ft., From ft. to ft.
 From ft. to ft., From ft. to ft.
 GRAVEL PACK INTERVALS: From 318 ft. to 210 ft., From 200 ft. to 23 ft.
 From ft. to ft., From ft. to ft.

GROUT MATERIAL: 1 Neat cement 2 Cement grout 3 Bentonite 4 Other
 Grout Intervals: From 210 ft. to 200 ft., From 23 ft. to 0 ft., From ft. to ft.
 What is the nearest source of possible contamination: None of kind of Drilling
 1 Septic tank 4 Lateral lines 7 Pit privy 11 Fuel storage 14 Abandoned water well
 2 Sewer lines 5 Cess pool 8 Sewage lagoon 12 Fertilizer storage 15 Oil well/Gas well
 3 Watertight sewer lines 6 Seepage pit 9 Feedyard 13 Insecticide storage 16 Other (specify below)
 Direction from well? How many feet?

FROM	TO	LITHOLOGIC LOG	FROM	TO	PLUGGING INTERVALS
0	2	Soil + clay			
2	6	Limestone			
6	33	Shale			
33	35	Limestone			
35	143	Shale			
143	150	Limestone			
150	153	Limy sandstone			
153	155	Shale			
155	238	Sandy shale			
238	314	Coarse sandstone			
314	318	Limestone			

CONTRACTOR'S OR LANDOWNER'S CERTIFICATION: This water well was (1) constructed, (2) reconstructed, or (3) plugged under my jurisdiction and was completed on (mo/day/year) 6-27-01 and this record is true to the best of my knowledge and belief. Kansas Water Well Contractor's Licence No. 561 This Water Well Record was completed on (mo/day/yr) 6-27-01 under the business name of EVANS Energy Dev. Inc. by signature Scott G. Evans