

CORRECTION(S) TO WATER WELL RECORD (WWC-5)

(to rectify lacking or incorrect information)

County: Douglas

Location listed as:

Section-Township-Range: 31-12-20E

Fraction (1/4 1/4 1/4): SW SW NW

Location changed to:

31-12S-20E

S2 SE NW

Other changes: Initial statements: _____

Changed to: _____

Comments: _____

verification method: well site address, city street map, and mapping tool on KGS website.

initials: ERT date: 9/29/2010


submitted by: Kansas Geological Survey, Data Resources Library, 1930 Constant Ave., Lawrence, KS 66047-3726
to: Kansas Dept of Health & Environment, Bureau of Water, 1000 SW Jackson, Suite 420, Topeka, KS 66612-1367.

1	LOCATION OF WATER WELL:	Fraction	Section Number	Township Number	Range Number
	County: <u>DOUGLAS</u>	<u>SW 1/4 SW 1/4 NW 1/4</u>	<u>31</u>	<u>12</u>	<u>20E</u>

Distance and direction from nearest town or city street address of well if located within city?
1002 NEW HAMPSHIRE, LAWRENCE, KS

2 WATER WELL OWNER: COVIE CRAMER
2411 MANCHESTER
 RR #, St. Address, Box #: LAWRENCE, KS 66044
 City, State, ZIP Code : LAWRENCE, KS 66044

Board of Agriculture, Division of Water Resources
 Application Number: _____

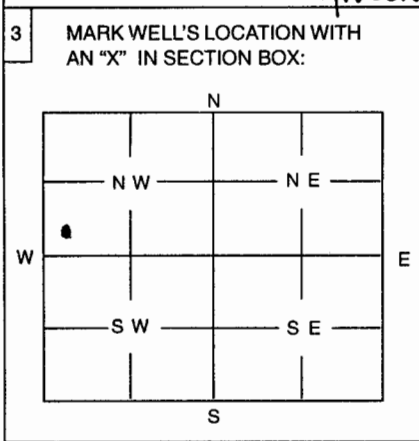

4 DEPTH OF WELL 17 ft
 WELL'S STATIC WATER LEVEL 6.71 ft.

WELL WAS USED AS:

1 Domestic	5 Public Water Supply	9 Dewatering
2 Irrigation	6 Oil Field Water Supply	10 Monitoring Well
3 Feedlot	7 Domestic (Lawn & Garden)	11 Injection Well
4 Industrial	8 Air Conditioning	12 Other

Was a chemical / bacteriological sample submitted to Department? Yes No

If yes, mo/day/yr sample was submitted

Water Well Disinfected: Yes No

5 TYPE OF BLANK CASING USED:

1 Steel	3 RMP (SR)	5 Wrought	7 Fiberglass	9 Other (Specify below)
2 PVC	4 ABS	6 Asbestos-Cement	8 Concrete Tile

Blank casing diameter 2.375 in. Was casing pulled? Yes No If yes, how much

Casing height above or below land surface N/A in.

6 GROUT PLUG MATERIAL: 1 Neat cement 2 Cement grout 3 Bentonite 4 Other SOILS

Grout Plug Intervals: From 17 ft. to 3 ft., From 3 ft. to 0 ft., From to ft.

What is the nearest source of possible contamination:

1 Septic tank	6 Seepage pit	<u>11</u> Fuel storage (<u>FUELMER</u>)	16 Other (specify below)
2 Sewer lines	7 Pit privy	12 Fertilizer storage
3 Watertight sewer lines	8 Sewage lagoon	13 Insecticide storage
4 Lateral lines	9 Feedyard	14 Abandoned water well
5 Cess Pool	10 Livestock pens	15 Oil well/Gas well

Direction from well? SOUTH How many feet? 20

FROM	TO	PLUGGING MATERIALS
<u>0</u>	<u>3</u>	<u>COMPACTED SOILS</u>
<u>3</u>	<u>17</u>	<u>BENTONITE CHIPS</u>

7 CONTRACTOR'S OR LANDOWNER'S CERTIFICATION: This water well was plugged under my jurisdiction and was completed on (mo/day/year) and this record is true to the best of my knowledge and belief. Kansas Water Well Contractor's License No. 7115/01 under the business name of QUAD STATE SERVICES, INC. This Water Well Record was completed on (mo/day/year) by (signature) [Signature]

INSTRUCTIONS: Use typewriter or ball point pen. Please press firmly and print clearly. Please fill in blanks, underline or circle the correct answers. Send top three copies to Kansas Department of Health and Environment, Bureau of Water, Topeka, Kansas 66620-0001. Telephone: 785/296-3565. Send one to Water Well Owner and retain one for your records.