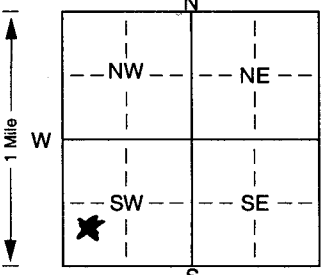


1 LOCATION OF WATER WELL: Fraction NW 1/4 SW 1/4 SW 1/4 Section Number 2 Township Number T 12 S Range Number R 20 E  
 County: Leavenworth

Distance and direction from nearest town or city street address of well if located within city?  
24850 Chieftain Rd. Lawrence, Ks. 66044

2 WATER WELL OWNER: Jeff Hill  
 RR#, St. Address, Box #: 2604 Crossgate Drive Board of Agriculture, Division of Water Resources  
 City, State, ZIP Code: Lawrence, Ks. 66047 Application Number:

3 LOCATE WELL'S LOCATION WITH AN "X" IN SECTION BOX:  
  
 4 DEPTH OF COMPLETED WELL: 300 ft. ELEVATION:  
 Depth(s) Groundwater Encountered: 1. 200-292 ft. 2. .ft. 3. .ft.  
 WELL'S STATIC WATER LEVEL: 198 ft. below land surface measured on mo/day/yr 3-27-02  
 Pump test data: Well water was .ft. after .hours pumping .gpm  
 Est. Yield 2.5 gpm; Well water was .ft. after .hours pumping .gpm  
 Bore Hole Diameter: 8 3/4 in. to 30.0 in. to .in. to .ft.  
 WELL WATER TO BE USED AS:  
 Domestic  Feedlot  Oil field water supply  Dewatering  Other (Specify below)  
 Irrigation  Industrial  Domestic (lawn & garden)  Monitoring well  
 Was a chemical/bacteriological sample submitted to Department? Yes. . No  ; If yes, mo/day/yr sample was submitted  
 Water Well Disinfected? Yes  No

5 TYPE OF BLANK CASING USED:  
 1 Steel  3 RMP (SR)  6 Asbestos-Cement  9 Other (specify below)   
 PVC  4 ABS  7 Fiberglass   
 Blank casing diameter: 5 in. to 280 ft., Dia. 5 in. to 290-300 ft., Dia. .in. to .ft.  
 Casing height above land surface: 30 in., weight SDR21 200 lbs/ft. Wall thickness or gauge No. .  
 TYPE OF SCREEN OR PERFORATION MATERIAL:  
 1 Steel  3 Stainless steel  5 Fiberglass  8 RMP (SR)  10 Asbestos-cement   
 2 Brass  4 Galvanized steel  6 Concrete tile  9 ABS  11 Other (specify)  12 None used (open hole)   
 SCREEN OR PERFORATION OPENINGS ARE:  
 1 Continuous slot  3 Mill slot  5 Gauzed wrapped  8 Saw cut  11 None (open hole)   
 2 Louvered shutter  4 Key punched  6 Wire wrapped  9 Drilled holes   
 7 Torch cut  10 Other (specify) .ft.  
 SCREEN-PERFORATED INTERVALS: From 280 ft. to 290 ft., From .ft. to .ft.  
 From .ft. to .ft., From .ft. to .ft.  
 GRAVEL PACK INTERVALS: From 300 ft. to 25 ft., From .ft. to .ft.  
 From .ft. to .ft., From .ft. to .ft.

6 GROUT MATERIAL: 1 Neat cement  2 Cement grout  3 Bentonite  4 Other .  
 Grout Intervals: From 280 ft. to 290 ft., From 25 ft. to 0 ft., From .ft. to .ft.  
 What is the nearest source of possible contamination:  
 Septic tank  Lateral lines  Pit privy  10 Livestock pens  14 Abandoned water well  
 2 Sewer lines  5 Cess pool  8 Sewage lagoon  11 Fuel storage  15 Oil well/Gas well  
 3 Watertight sewer lines  6 Seepage pit  9 Feedyard  12 Fertilizer storage  16 Other (specify below)  
 13 Insecticide storage .  
 Direction from well? NE - NW How many feet? 150

FROM	TO	LITHOLOGIC LOG	FROM	TO	PLUGGING INTERVALS
<u>0</u>	<u>5</u>	<u>So. 1 + clay</u>			
<u>5</u>	<u>183</u>	<u>Shale</u>			
<u>183</u>	<u>292</u>	<u>Sandstone</u>			
<u>292</u>	<u>300</u>	<u>Limestone</u>			

7 CONTRACTOR'S OR LANDOWNER'S CERTIFICATION: This water well was  constructed,  reconstructed, or  plugged under my jurisdiction and was completed on (mo/day/year) 3-27-02 and this record is true to the best of my knowledge and belief. Kansas Water Well Contractor's Licence No. 561. This Water Well Record was completed on (mo/day/yr) 3-28-02 under the business name of Evans Energy Dev. Inc. by (signature) Scott E. Evans