

CORRECTION(S) TO WATER WELL RECORD (WWC-5)
(to rectify lacking or incorrect information)

Location listed as:

Section-Township-Range: 31-12 S-20 E

Fraction ($\frac{1}{4}$ $\frac{1}{4}$ $\frac{1}{4}$): NE SE NW

County: Douglas

Location changed to:

31-12 S-20 E

N2 SE NW

Other changes: Initial statements: _____

Changed to: _____

Comments: _____

verification method: well site address, city street map, and mapping tool on KGS website.

initials: _____ date: _____

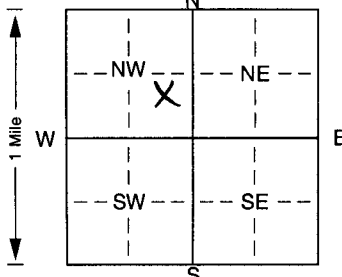
submitted by: Kansas Geological Survey, Data Resources Library, 1930 Constant Ave., Lawrence, KS 66047-3726
to: Kansas Dept of Health & Environment, Bureau of Water, 1000 SW Jackson, Suite 420, Topeka, KS 66612-1367.

MW5

1 LOCATION OF WATER WELL: Fraction NE 1/4 SE 1/4 NW 1/4 Section Number 31 Township Number T 12 S Range Number R 20 @W
 County: Douglas

Distance and direction from nearest town or city street address of well if located within city?
900 Newhamshire Lawrence Kansas

2 WATER WELL OWNER: Jeff Schmalberg
 RR#, St. Address, Box #: 1029 New Hampshire Board of Agriculture, Division of Water Resources
 City, State, ZIP Code: Lawrence Kansas 66044 Application Number:

3 LOCATE WELL'S LOCATION WITH AN "X" IN SECTION BOX:

 4 DEPTH OF COMPLETED WELL: 18 ft. ELEVATION: 841.75
 Depth(s) Groundwater Encountered: 1 ft. 6 ft. 3 ft.
 WELL'S STATIC WATER LEVEL: 6.43 ft. below land surface measured on mo/day/yr 10/23/02
 Pump test data: Well water was _____ ft. after _____ hours pumping _____ gpm
 Est. Yield _____ gpm: Well water was _____ ft. after _____ hours pumping _____ gpm
 Bore Hole Diameter: 8.25 in. to 18 ft., and _____ in. to _____ ft.
 WELL WATER TO BE USED AS:
 5 Public water supply 8 Air conditioning 11 Injection well
 1 Domestic 3 Feedlot 6 Oil field water supply 9 Dewatering 12 Other (Specify below)
 2 Irrigation 4 Industrial 7 Domestic (lawn & garden) Monitoring well
 Was a chemical/bacteriological sample submitted to Department? Yes No ; If yes, mo/day/yrs sample was submitted _____
 Water Well Disinfected? Yes No

5 TYPE OF BLANK CASING USED:
 1 Steel 3 RMP (SR) 5 Wrought iron 8 Concrete tile CASING JOINTS: Glued _____ Clamped _____
 PVC 4 ABS 6 Asbestos-Cement 9 Other (specify below) Welded _____
 7 Fiberglass _____ Threaded PVC
 Blank casing diameter 10.206 in. to 8 ft., Dia _____ in. to _____ ft., Dia _____ in. to _____ ft.
 Casing height above land surface: 3.00 in., weight 0.8 lbs./ft. Wall thickness or gauge No. SCH 40
 TYPE OF SCREEN OR PERFORATION MATERIAL:
 1 Steel 3 Stainless steel 5 Fiberglass 8 RMP (SR) 10 Asbestos-cement
 2 Brass 4 Galvanized steel 6 Concrete tile 9 ABS 11 Other (specify) _____
 12 None used (open hole)
 SCREEN OR PERFORATION OPENINGS ARE:
 1 Continuous slot 3 Mill slot 5 Gauzed wrapped 8 Saw cut 11 None (open hole)
 2 Louvered shutter 4 Key punched 6 Wire wrapped 9 Drilled holes
 7 Torch cut 10 Other (specify) _____ ft.
 SCREEN-PERFORATED INTERVALS: From 8 ft. to 18 ft., From _____ ft. to _____ ft.
 From _____ ft. to _____ ft., From _____ ft. to _____ ft.
 GRAVEL PACK INTERVALS: From 6 ft. to 18 ft., From _____ ft. to _____ ft.
 From _____ ft. to _____ ft., From _____ ft. to _____ ft.

6 GROUT MATERIAL: 1 Neat cement 2 Cement grout Bentonite 4 Other _____
 Grout Intervals: From _____ ft. to _____ ft., From _____ ft. to _____ ft., From _____ ft. to _____ ft.
 What is the nearest source of possible contamination:
 1 Septic tank 4 Lateral lines 7 Pit privy 10 Livestock pens 14 Abandoned water well
 2 Sewer lines 5 Cess pool 8 Sewage lagoon 11 Fuel storage 15 Oil well/Gas well
 3 Watertight sewer lines 6 Seepage pit 9 Feedyard 12 Fertilizer storage Other (specify below) LUST SITE
 13 Insecticide storage _____
 Direction from well? _____ How many feet? _____

FROM	TO	LITHOLOGIC LOG	FROM	TO	PLUGGING INTERVALS
0'	0.5'	Concrete			
0.5'	8'	Clay, red brown, silty, slightly sandy, very dense, low plasticity, NO odor (TILL) / CL			
8'	18'	Clay, yellow-brown, dense, dry, low plasticity, NO odor, (TILL) / CL			

7 CONTRACTOR'S OR LANDOWNER'S CERTIFICATION: This water well was (1) constructed, (2) reconstructed, or (3) plugged under my jurisdiction and was completed on (mo/day/year) 10/22/02 and this record is true to the best of my knowledge and belief. Kansas Water Well Contractor's Licence No. 594 This Water Well Record was completed on (mo/day/yr) 11/01/02 under the business name of Coranco Great Plains Inc by (signature) [Signature]