


MW-6

| | | | | | | | | |
|---|-------------------------|-----------------------------|-----------|--------|------------|--------|------------|--------|
| 1 | LOCATION OF WATER WELL: | Fraction | Section | Number | Township | Number | Range | Number |
| | County: DOUGLAS | NE 1/4 SE 1/4 SW 1/4 | 19 | | 12S | | 20E | |

Distance and direction from nearest town or city street address of well if located within city?
1001 North 3rd St. Lawrence Kansas

2 WATER WELL OWNER: **HERB BEHLOW**

RR #, St. Address, Box #: **Lawrence, Kansas** Board of Agriculture, Division of Water Resources
 City, State, ZIP Code : Application Number:

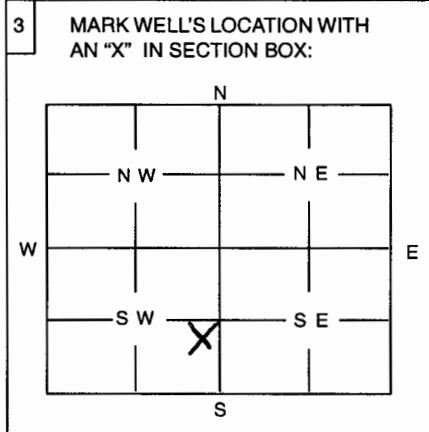

4 DEPTH OF WELL **9.84** ft

WELL'S STATIC WATER LEVEL **8.53** ft.

WELL WAS USED AS:

| | | |
|--------------|----------------------------|---------------------------|
| 1 Domestic | 5 Public Water Supply | 9 Dewatering |
| 2 Irrigation | 6 Oil Field Water Supply | <u>10</u> Monitoring Well |
| 3 Feedlot | 7 Domestic (Lawn & Garden) | 11 Injection Well |
| 4 Industrial | 8 Air Conditioning | 12 Other |

Was a chemical / bacteriological sample submitted to Department? Yes No X

If yes, mo/day/yr sample was submitted

Water Well Disinfected: Yes No X

5 TYPE OF BLANK CASING USED:

1 Steel 3 RMP (SR) 5 Wrought 7 Fiberglass 9 Other (Specify below)

3 PVC 4 ABS 6 Asbestos-Cement 8 Concrete Tile

Blank casing diameter in. Was casing pulled? Yes X No If yes, how much

Casing height above or below land surface in.

6 GROUT PLUG MATERIAL: 1 Neat cement 2 Cement grout 3 Bentonite 4 Other

Grout Plug Intervals: From ft. to ft., From ft. to ft., From to ft.

What is the nearest source of possible contamination:

| | | | |
|--------------------------|-------------------|-------------------------|--------------------------|
| 1 Septic tank | 6 Seepage pit | <u>11</u> Fuel storage | 16 Other (specify below) |
| 2 Sewer lines | 7 Pit privy | 12 Fertilizer storage | |
| 3 Watertight sewer lines | 8 Sewage lagoon | 13 Insecticide storage | |
| 4 Lateral lines | 9 Feedyard | 14 Abandoned water well | |
| 5 Cess Pool | 10 Livestock pens | 15 Oil well/Gas well | |

Direction from well? **NE** How many feet? **unknown**

| FROM | TO | PLUGGING MATERIALS |
|------|-----|--------------------|
| 4.5 | 10 | Cement Grout |
| 2.5 | 4.5 | Bentonite |
| 0 | 2.5 | SOIL |
| | | |
| | | |
| | | |
| | | |

RECEIVED
OCT 07 2004
BUREAU OF WATER

7 CONTRACTOR'S OR LANDOWNER'S CERTIFICATION: This water well was plugged under my jurisdiction and was completed on (mo/day/year) **04/14/04** and this record is true to the best of my knowledge and belief. Kansas Water Well Contractor's License No. **714** This Water Well Record was completed on (mo/day/year) **09/29/04** under the business name of **Environmental Geoscience & Engineering** by (signature)

INSTRUCTIONS: Use typewriter or ball point pen. Please press firmly and print clearly. Please fill in blanks, underline or circle the correct answers. Send top three copies to Kansas Department of Health and Environment, Bureau of Water, Topeka, Kansas 66620-0001. Telephone: 785/296-3565. Send one to Water Well Owner and retain one for your records.