


1 LOCATION OF WATER WELL: County: Leavenworth Fraction: NW 1/4 NE 1/4 NE 1/4 Section Number: 1 Township Number: T 13 S Range Number: R 20 EW

Distance and direction from nearest town or city street address of well if located within city?
1 mi SW of Reno

2 WATER WELL OWNER: Stan McMeiham Board of Agriculture, Division of Water Resources
RR#, St. Address, Box #: RR Lawrence, Kans. Application Number:

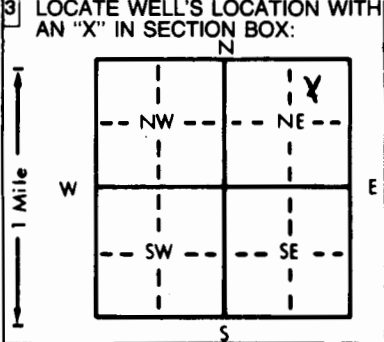

4 DEPTH OF COMPLETED WELL: 152 ft. ELEVATION: _____
Depth(s) Groundwater Encountered 1. 130 ft. 2. _____ ft. 3. _____ ft.
WELL'S STATIC WATER LEVEL 90 ft. below land surface measured on mo/day/yr 2-5-88
Pump test data: Well water was _____ ft. after _____ hours pumping _____ gpm
Est. Yield 20 gpm; Well water was _____ ft. after _____ hours pumping _____ gpm
Bore Hole Diameter 8" in. to 22 ft., and 6 1/4 in. to 152 ft.
WELL WATER TO BE USED AS: 5 Public water supply 8 Air conditioning 11 Injection well
 Domestic 3 Feedlot 6 Oil field water supply 9 Dewatering 12 Other (Specify below)
2 Irrigation 4 Industrial 7 Lawn and garden only 10 Observation well
Was a chemical/bacteriological sample submitted to Department? Yes _____ No If yes, mo/day/yr sample was submitted _____
Water Well Disinfected? Yes No

5 TYPE OF BLANK CASING USED: 1 Steel 3 RMP (SR) 5 Wrought iron 8 Concrete tile CASING JOINTS: Glued Clamped _____
2 PVC 4 ABS 6 Asbestos-Cement 9 Other (specify below) Welded _____
7 Fiberglass Threaded _____
Blank casing diameter 5 1/2 in. to 100 ft., Dia _____ in. to _____ ft., Dia _____ in. to _____ ft.
Casing height above land surface 24 in., weight _____ lbs./ft. Wall thickness or gauge No. SDR 26
TYPE OF SCREEN OR PERFORATION MATERIAL: PVC 10 Asbestos-cement
1 Steel 3 Stainless steel 5 Fiberglass 8 RMP (SR) 11 Other (specify) _____
2 Brass 4 Galvanized steel 6 Concrete tile 9 ABS 12 None used (open hole)
SCREEN OR PERFORATION OPENINGS ARE: 5 Gauzed wrapped 8 Saw cut 11 None (open hole)
1 Continuous slot 3 Mill slot 6 Wire wrapped Drilled holes
2 Louvered shutter 4 Key punched 7 Torch cut 10 Other (specify) _____
SCREEN-PERFORATED INTERVALS: From 100 ft. to 152 ft., From _____ ft. to _____ ft.
GRAVEL PACK INTERVALS: From _____ ft. to _____ ft., From _____ ft. to _____ ft.

6 GROUT MATERIAL: 1 Neat cement 2 Cement grout 3 Bentonite 4 Other _____
Grout Intervals: From 0 ft. to 22 ft., From _____ ft. to _____ ft., From _____ ft. to _____ ft.
What is the nearest source of possible contamination: 10 Livestock pens 14 Abandoned water well
1 Septic tank 4 Lateral lines 7 Pit privy 11 Fuel storage 15 Oil well/Gas well
2 Sewer lines 5 Cess pool 8 Sewage lagoon 12 Fertilizer storage 16 Other (specify below)
3 Watertight sewer lines 6 Seepage pit 9 Feedyard 13 Insecticide storage Unknown

Direction from well? _____ How many feet? 100+

FROM	TO	LITHOLOGIC LOG	FROM	TO	LITHOLOGIC LOG
0	4	TS.			
4	5	Lime			
5	13	Sandstone yellow			
13	16	Shale			
16	30	Sandy shale			
30	70	Shale			
70	95	Sandy shale			
95	120	Sandy shale			
120	151	Sandstone			
151	152	Lime			

7 CONTRACTOR'S OR LANDOWNER'S CERTIFICATION: This water well was (1) constructed, (2) reconstructed, or (3) plugged under my jurisdiction and was completed on (mo/day/year) 2-5-88 and this record is true to the best of my knowledge and belief. Kansas
Water Well Contractor's License No. 316 This Water Well Record was completed on (mo/day/yr) 2-9-88
under the business name of Robison Drilling by (signature) Jack Robison

INSTRUCTIONS: Use typewriter or ball point pen. PLEASE PRESS FIRMLY and PRINT clearly. Please fill in blanks, underline or circle the correct answers. Send top three copies to Kansas Department of Health and Environment, Bureau of Water Protection, Topeka, Kansas 66620-7320, Telephone: 913-862-9360. Send one to WATER WELL OWNER and retain one for your records.