WATER WELL RECORD Form WWC-5 KSA 82a-1212

1 LOCATION OF WATER WELL: County: Leavenworth	Fraction: SW ¼ SW ¼ ne ¼	Section Number: 1	Township Number: T 12s S	Range Number: R 20e E/W

Distance and direction from nearest town or city street address of well if located within city?
1 mile sw of Reno on 24/40 23949 Chieftain Rd Lawrence, KS

2 WATER WELL OWNER: John And ANN Hulsey
RR#, St. Address, Box # : 23949 Chieftain RD
City, State, ZIP Code : Lawrence, KS

Board of Agriculture, Division of Water Resources
Application Number:

3 LOCATE WELL'S LOCATION WITH AN "X" IN SECTION BOX:

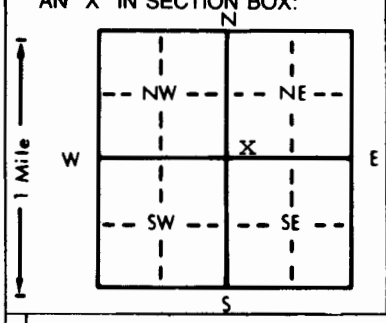

4 DEPTH OF COMPLETED WELL 151 ft. ELEVATION: 890'
Depth(s) Groundwater Encountered 1. 110 ft. 2. ft. 3. ft.
WELL'S STATIC WATER LEVEL 81 ft. below land surface measured on mo/day/yr 4-3-92
Pump test data: Well water was ft. after hours pumping gpm
Est. Yield 50 gpm: Well water was ft. after hours pumping gpm
Bore Hole Diameter 8 1/4 in. to ft., and in. to ft.
WELL WATER TO BE USED AS #1 5 Public water supply 8 Air conditioning 11 Injection well
(1 Domestic) 3 Feedlot 6 Oil field water supply 9 Dewatering 12 Other (Specify below)
2 Irrigation 4 Industrial 7 Lawn and garden only 10 Monitoring well
Was a chemical/bacteriological sample submitted to Department? Yes No X; If yes, mo/day/yr sample was submitted
Water Well Disinfected? Yes X No

5 TYPE OF BLANK CASING USED: #2 5 Wrought iron 8 Concrete tile CASING JOINTS: Glued X Clamped
1 Steel 3 RMP (SR) 6 Asbestos-Cement 9 Other (specify below) Welded
2 PVC 4 ABS 7 Fiberglass Threaded
Blank casing diameter 5" in. to 110 ft., Dia 5" in. to 125-147 ft., Dia in. to ft.
Casing height above land surface 24" in., weight .285 lbs./ft. Wall thickness or gauge No. .265
TYPE OF SCREEN OR PERFORATION MATERIAL: #7 7 PVC 10 Asbestos-cement
1 Steel 3 Stainless steel 5 Fiberglass 8 RMP (SR) 11 Other (specify)
2 Brass 4 Galvanized steel 6 Concrete tile 9 ABS 12 None used (open hole)
SCREEN OR PERFORATION OPENINGS ARE: #3 5 Gauzed wrapped 8 Saw cut 11 None (open hole)
1 Continuous slot 3 Mill slot 6 Wire wrapped 9 Drilled holes
2 Louvered shutter 4 Key punched 7 Torch cut 10 Other (specify)
SCREEN-PERFORATED INTERVALS: From 110 ft. to 125 ft., From ft. to ft.
From 147 ft. to 151 ft., From ft. to ft.
GRAVEL PACK INTERVALS: From 20 ft. to 151 ft., From ft. to ft.
From ft. to ft., From ft. to ft.

6 GROUT MATERIAL: #1 1 Neat cement 2 Cement grout 3 Bentonite 4 Other
Grout Intervals: From 20 ft. to 4' ft., From ft. to ft., From ft. to ft.
What is the nearest source of possible contamination: #1 10 Livestock pens 14 Abandoned water well
1 Septic tank 4 Lateral lines 7 Pit privy 11 Fuel storage 15 Oil well/Gas well
2 Sewer lines 5 Cess pool 8 Sewage lagoon 12 Fertilizer storage 16 Other (specify below)
3 Watertight sewer lines 6 Seepage pit 9 Feedyard 13 Insecticide storage
Direction from well? west How many feet? 200'

FROM	TO	LITHOLOGIC LOG	FROM	TO	PLUGGING INTERVALS
0	05	top soil			
05	25	shale			
25	50	clay			
50	88	sandstone gray dirty			
88	140	sandstone verry clean			
140	151	sandstone gray dirty			

7 CONTRACTOR'S OR LANDOWNER'S CERTIFICATION: This water well was (1) constructed, (2) reconstructed, or (3) plugged under my jurisdiction and was completed on (mo/day/year) 4-3-92 and this record is true to the best of my knowledge and belief. Kansas Water Well Contractor's License No. 174 This Water Well Record was completed on (mo/day/yr) 4-7-92
under the business name of Breuer Inc. by (signature) John S. Breuer

INSTRUCTIONS: Use typewriter or ball point pen. *PLEASE PRESS FIRMLY* and *PRINT* clearly. Please fill in blanks, underline or circle the correct answers. Send top three copies to Kansas Department of Health and Environment, Bureau of Water, Topeka, Kansas 66620-0001. Telephone: 913-296-5545. Send one to WATER WELL OWNER and retain one for your records.