


1) LOCATION OF WATER WELL: County: LEAVENWORTH Fraction SW 1/4 SW 1/4 SW 1/4 Section Number 1 Township Number T 12 S Range Number R 20 E/W

Distance and direction from nearest town or city street address of well if located within city?

1 1/2 south, 1 1/2 west of Reno

2) WATER WELL OWNER: Bob Soetaert RR#, St. Address, Box #: 207 Green St. City, State, ZIP Code: Tonganoxie, KS 66086 Board of Agriculture, Division of Water Resources Application Number:

3) LOCATE WELL'S LOCATION WITH AN "X" IN SECTION BOX:

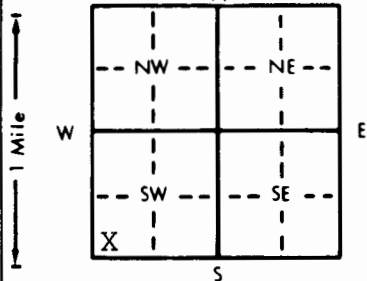

4) DEPTH OF COMPLETED WELL: 150' ft. ELEVATION: ... ft. Depth(s) Groundwater Encountered 1. ... ft. 2. ... ft. 3. ... ft. WELL'S STATIC WATER LEVEL: 49' ft. below land surface measured on mo/day/yr 09/18/98 Pump test data: Well water was ... ft. after ... hours pumping ... gpm Est. Yield: 30 gpm Well water was ... ft. after ... hours pumping ... gpm Bore Hole Diameter: 8 3/4 in. to ... ft., and ... in. to ... ft. WELL WATER TO BE USED AS: 5 Public water supply 8 Air conditioning 11 Injection well 1 Domestic 3 Feedlot 6 Oil field water supply 9 Dewatering 12 Other (Specify below) 2 Irrigation 4 Industrial 7 Lawn and garden only 10 Monitoring well Was a chemical/bacteriological sample submitted to Department? Yes ... No If yes, mo/day/yr sample was submitted Water Well Disinfected? Yes No

5) TYPE OF BLANK CASING USED: 1 Steel 3 RMP (SR) 5 Wrought iron 8 Concrete tile CASING JOINTS: Glued Clamped ... 2 PVC 4 ABS 6 Asbestos-Cement 9 Other (specify below) Welded ... 7 Fiberglass Threaded ... Blank casing diameter: 5" in. to 0-103 ft., Dia 5" in. to 143-150 ft., Dia ... in. to ... ft. Casing height above land surface: 24" in., weight 2.82 lbs./ft. Wall thickness or gauge No. 258 TYPE OF SCREEN OR PERFORATION MATERIAL: 1 Steel 3 Stainless steel 5 Fiberglass 7 PVC 10 Asbestos-cement 2 Brass 4 Galvanized steel 6 Concrete tile 8 RMP (SR) 11 Other (specify) ... 9 ABS 12 None used (open hole) SCREEN OR PERFORATION OPENINGS ARE: 1 Continuous slot 3 Mill slot 5 Gauzed wrapped 8 Saw cut 11 None (open hole) 2 Louvered shutter 4 Key punched 6 Wire wrapped 9 Drilled holes 10 Other (specify) ... SCREEN-PERFORATED INTERVALS: From 103 ft. to 143 ft., From ... ft. to ... ft. GRAVEL PACK INTERVALS: From 24 ft. to 150 ft., From ... ft. to ... ft.

6) GROUT MATERIAL: 1 Neat cement 2 Cement grout 3 Bentonite 4 Other Grout Intervals: From 4 ft. to 24 ft., From ... ft. to ... ft. What is the nearest source of possible contamination: 1 Septic tank 4 Lateral lines 7 Pit privy 10 Livestock pens 14 Abandoned water well 2 Sewer lines 5 Cess pool 8 Sewage lagoon 11 Fuel storage 15 Oil well/Gas well 3 Watertight sewer lines 6 Seepage pit 9 Feedyard 12 Fertilizer storage 16 Other (specify below) 13 Insecticide storage Direction from well? WEST How many feet? 110'

FROM	TO	LITHOLOGIC LOG	FROM	TO	PLUGGING INTERVALS
0	2	Top Soil			
2	5	Clay-Brown			
5	45	Sandy Shale-Grey			
45	47	Limestone-Grey			
47	143	Sandstone-Grey			
143	150	Limestone-Grey			

7) CONTRACTOR'S OR LANDOWNER'S CERTIFICATION: This water well was (1) constructed, (2) reconstructed, or (3) plugged under my jurisdiction and was completed on (mo/day/year) 09/18/98 and this record is true to the best of my knowledge and belief. Kansas Water Well Contractor's License No. 182 This Water Well Record was completed on (mo/day/yr) 9-30-98 under the business name of STRADER DRILLING CO., INC. by (signature) Dale Strader