


1 LOCATION OF WATER WELL: County: <u>Leavenworth</u>	Fraction <u>NW 1/4 SE 1/4 SW 1/4</u>	Section Number <u>2</u>	Township Number <u>T 12 S</u>	Range Number <u>R 20 EW</u>
---	---	----------------------------	----------------------------------	--------------------------------

Distance and direction from nearest town or city street address of well if located within city?
6 miles south of Tonganoxie on west side of Highway 39

2 WATER WELL OWNER: Mark Hendrix
 RR#, St. Address, Box # : 2025 E. 26th Ter
 City, State, ZIP Code : Lawrence, KS 66046
 Board of Agriculture, Division of Water Resources
 Application Number:

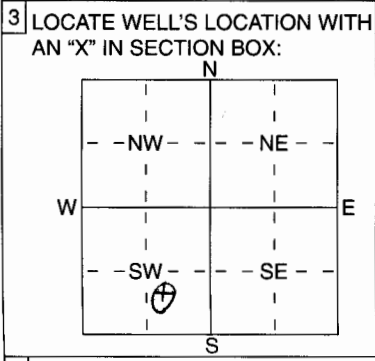

4 DEPTH OF COMPLETED WELL ...250... ft. ELEVATION:

Depth(s) Groundwater Encountered 1 ...190-220... ft. 2 ft. 3 ft.

WELL'S STATIC WATER LEVEL ...5.3... ft. below land surface measured on mo/day/yr ...3/14/05.....

Pump test data: Well water was ft. after hours pumping gpm

Est. Yield ...3.5... gpm: Well water was ft. after hours pumping gpm

WELL WATER TO BE USED AS: 5 Public water supply 8 Air conditioning 11 Injection well
 1 Domestic 3 Feedlot 6 Oil field water supply 9 Dewatering 12 Other (Specify below)
 2 Irrigation 4 Industrial 7 Domestic (lawn & garden) 10 Monitoring well

Was a chemical/bacteriological sample submitted to Department? Yes No ...X...; If yes, mo/day/yr sample was submitted
 Water Well Disinfected? Yes X No

5 TYPE OF BLANK CASING USED: 1 Steel 3 RMP (SR) 5 Wrought iron 8 Concrete tile CASING JOINTS: Glued ...X... Clamped
 2 PVC 4 ABS 6 Asbestos-Cement 9 Other (specify below) Welded
 7 Fiberglass Threaded

Blank casing diameter5... in. to1.90... ft. Dia5... in. to230-250... ft. Dia in. to ft.

Casing height above land surface18... in., weight SDR 21 lbs./ft. Wall thickness or gauge No. 200PSI

TYPE OF SCREEN OR PERFORATION MATERIAL: 1 Steel 3 Stainless Steel 5 Fiberglass 7 PVC 10 Asbestos-Cement
 2 Brass 4 Galvanized Steel 6 Concrete tile 8 RMP (SR) 11 Other (Specify)
 9 ABS 12 None used (open hole)

SCREEN OR PERFORATION OPENINGS ARE: 1 Continuous slot 2 Louvered shutter 3 Mill slot 4 Key punched 5 Gauzed wrapped 6 Wire wrapped 7 Torch cut 8 Saw cut 9 Drilled holes 11 None (open hole)
 10 Other (specify) ft.

SCREEN-PERFORATED INTERVALS: From1.90... ft. to2.30... ft., From ft. to ft.
 From ft. to ft., From ft. to ft.

GRAVEL PACK INTERVALS: From2.5... ft. to2.50... ft., From ft. to ft.
 From ft. to ft., From ft. to ft.

6 GROUT MATERIAL: 1 Neat cement 2 Cement grout 3 Bentonite 4 Other

Grout intervals: From0... ft. to2.5... ft., From ft. to ft., From ft. to ft.

What is the nearest source of possible contamination: 1 Septic tank 4 Lateral lines 7 Pit privy 10 Livestock pens 14 Abandoned water well
 2 Sewer lines 5 Cess pool 8 Sewage lagoon 11 Fuel storage 15 Oil well/Gas well
 3 Watertight sewer lines 6 Seepage pit 9 Feedyard 12 Fertilizer storage 16 Other (specify below)
 13 Insecticide storage

Direction from well? NOTHING YET How many feet? NOTHING YET

FROM	TO	LITHOLOGIC LOG	FROM	TO	PLUGGING INTERVALS
0	13	Clay			
13	17	Limestone			
17	22	Coal & Shale			
22	32	Limestone			
32	57	Shale			
57	60	Sandstone			
60	168	Shale			
168	180	Slight show of oil in sandstone			
180	226	Sandstone (water)			
226	250	Limestone			

7 CONTRACTOR'S OR LANDOWNER'S CERTIFICATION: This water well was (1) constructed, (2) reconstructed, or (3) plugged under my jurisdiction and was completed on (mo/day/year)3/16/05..... and this record is true to the best of my knowledge and belief. Kansas Water Well Contractor's Licence No595..... This Water Well Record was completed on (mo/day/yr)4/26/05..... under the business name of Jesse Yoakum Well Drilling by (signature)

INSTRUCTIONS: Use typewriter or ball point pen. PLEASE PRESS FIRMLY and PRINT clearly. Please fill in blanks, underline or circle the correct answers. Send top three copies to Kansas Department of Health and Environment, Bureau of Water, Geology Section, 1000 SW Jackson St., Suite 420, Topeka, Kansas 66612-1367. Telephone 785-296-5522. Send one to WATER WELL OWNER and retain one for your records. Fee of \$5.00 for each constructed well.