CORRECTION(S) TO WATER WELL RECORD (WWC-5)

(to rectify lacking or incorrect information)

County: Douglas

Location listed as:	**Location ~~changed to~~:**
Section-Township-Range:	29 - 12 S - 20 E
Fraction (¼ ¼ ¼):	NW NE SE

Other changes: Initial statements: Jefferson County

Changed to: Douglas County

Comments:

verification method: Written & legal descriptions, city street map, and mapping tool & aerial photos on KGS website.

initials: DRL date: 12/21/2005

submitted by: Kansas Geological Survey, Data Resources Library, 1930 Constant Ave., Lawrence, KS 66047-3726
to: Kansas Dept of Health & Environment, Bureau of Water, 1000 SW Jackson, Suite 420, Topeka, KS 66612-1367.

WATER WELL PLUGGING RECORD Form WWC-5P KSA 82a-1212 ID NO._____

1 LOCATION OF WATER WELL:	Fraction	Section Number	Township Number	Range Number
County: Jefferson	NW¼ NE ¼ SE ¼	29	12 S	20 (E)/W

Distance and direction from nearest town or city street address of well if located within city?
Corner of 9th and Oak St., Lawrence, KS

2 WATER WELL OWNER: FMC Corp.
1735 Market St.
RR #, St. Address, Box #: Philadelphia, PA 19103
City, State, ZIP Code : Board of Agriculture, Division of Water Resources Application Number:

3 MARK WELL'S LOCATION WITH AN "X" IN SECTION BOX:

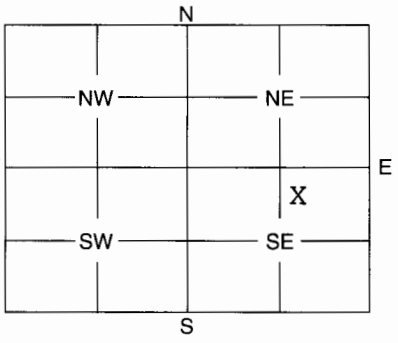

4 DEPTH OF WELL 46.3 ft.

WELL'S STATIC WATER LEVEL 18.2 ft.

WELL WAS USED AS:

1 Domestic 5 Public Water Supply 9 Dewatering
2 Irrigation 6 Oil Field Water Supply (10) Monitoring Well
3 Feedlot 7 Domestic (Lawn & Garden) 11 Injection Well
4 Industrial 8 Air Conditioning 12 Other .....

Was a chemical / bacteriological sample submitted to Department? Yes ..... No X
If yes, mo/day/yr sample was submitted .....

Water Well Disinfected: Yes ..... No X

5 TYPE OF BLANK CASING USED:

(1) Steel 3 RMP (SR) 5 Wrought 7 Fiberglass 9 Other (Specify below)
2 PVC 4 ABS 6 Asbestos-Cement 8 Concrete Tile .....

Blank casing diameter 4 in. Was casing pulled? Yes ..... No X If yes, how much .....
Casing height above or (below) land surface 36" in.

6 GROUT PLUG MATERIAL: 1 Neat cement 2 Cement grout 3 Bentonite (4) Other Bentonite chips

Grout Plug Intervals: From 46.3 ft. to 3.0 ft., From ..... ft. to ..... ft., From ..... to ..... ft.

What is the nearest source of possible contamination:

1 Septic tank 6 Seepage pit 11 Fuel storage (12) Other (specify below)
2 Sewer lines 7 Pit privy 12 Fertilizer storage Farm field
3 Watertight sewer lines 8 Sewage lagoon 13 Insecticide storage
4 Lateral lines 9 Feedyard 14 Abandoned water well
5 Cess pool 10 Livestock pens 15 Oil well/Gas well

Direction from well? N/A How many feet? N/A

FROM	TO	PLUGGING MATERIALS
46.3	3.0	Bentonite chips
3.0	0	Top soil

FMC-D-1

7 CONTRACTOR'S OF LANDOWNER'S CERTIFICATION: This water well was plugged under my jurisdiction and was completed on (mo/day/year) 11-08-05 and this record is true to the best of my knowledge and belief. Kansas Water Well Contractor's License No. 665 This Water Well Record was completed on (mo/day/year) 11-10-05 under the business name of Pratt Well Environmental by (signature) Steven Eddy

INSTRUCTIONS: Use typewriter or ball point pen. Please press firmly and print clearly. Please fill in blanks, underline or circle the correct answers. Send top three copies to Kansas Department of Health and Environment, Bureau of Water, Geology Section, 1000 SW Jackson St., Ste. 420, Topeka, Kansas 66612-1367. Telephone: 785/296-5522. Send one to Water Well Owner and retain one for your records.