


1 LOCATION OF WATER WELL: County: **Douglas** Fraction: **SW 1/4 NW 1/4 NW 1/4** Section Number: **31** Township Number: **T 12 S** Range Number: **R 20E EW**
 Distance and direction from nearest town or city street address of well if located within city?
829 Ohio St, Lawrence KS 66044. S side of property

2 WATER WELL OWNER: **KDHE-BER**
 RR#, St. Address, Box #: **Presto Convenience Store #25** Board of Agriculture, Division of Water Resources
 City, State, ZIP Code: **U4-023-13799** Application Number:

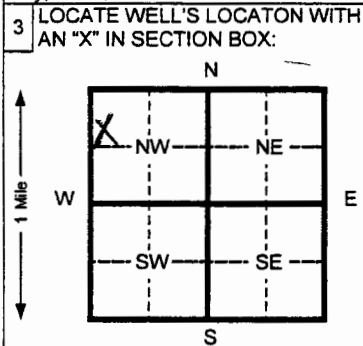

4 DEPTH OF COMPLETED WELL: **20** ft. ELEVATION: **854.16 TOC**
 Depth(s) Groundwater Encountered: 1 _____ ft. 2 _____ ft. 3 _____ ft.
 WELL'S STATIC WATER LEVEL: **9.91** ft. below land surface measured on **6/9/05**
 Pump test data: Well water was _____ ft. after _____ hours pumping _____ gpm
 Est. Yield _____ gpm: Well water was _____ ft. after _____ hours pumping _____ gpm
 Bore Hole Diameter _____ in. to _____ ft. and _____ in. to _____ ft.
 WELL WATER TO BE USED AS: 5 Public water supply 8 Air conditioning 11 Injection well
 1 Domestic 3 Feed lot 6 Oil field water supply 9 Dewatering 12 Other (Specify below)
 2 Irrigation 4 Industrial 7 Lawn and garden (domestic) **10' Monitoring well**
 Was a chemical/bacteriological sample submitted to Department? Yes _____ No **X** If yes, mo/day/yr sample was submitted _____
 Water Well Disinfected? Yes _____ No **X**

5 TYPE OF BLANK CASING USED: 1 Steel 3 RMP (SR) 5 Wrought Iron 8 Concrete tile CASING JOINTS: Glued _____ Clamped _____
2 PVC 4 ABS 6 Asbestos-Cement 9 Other (specify below) Welded _____
 7 Fiberglass Threaded **X**
 Blank casing diameter **2** in. to **20** ft. Dia _____ in. to _____ ft. Dia _____ in. to _____ ft.
 Casing height above land surface **0** in., weight _____ lbs./ft. Wall thickness or gauge No. _____
 TYPE OF SCREEN OR PERFORATION MATERIAL: **7 PVC** 10 Asbestos-cement
 1 Steel 3 Stainless steel 5 Fiberglass 8 RMP (SR) 11 Other (specify) _____
 2 Brass 4 Galvanized steel 6 Concrete tile 9 ABS 12 None used (open hole) _____
 SCREEN OR PERFORATION OPENINGS ARE: 5 Gauzed wrapped 8 Saw cut 11 None (open hole)
 1 Continuous slot 3 Mill slot 6 Wire wrapped 9 Drilled holes
 2 Louvered shutter 4 Key punched 7 Torch cut 10 Other (specify) _____
 SCREEN-PERFORATED INTERVALS: From **5** ft. to **20** ft. From _____ ft. to _____ ft.
 From _____ ft. to _____ ft. From _____ ft. to _____ ft.
 GRAVEL PACK INTERVALS: From **3** ft. to **20** ft. From _____ ft. to _____ ft.
 From _____ ft. to _____ ft. From _____ ft. to _____ ft.

6 GROUT MATERIAL: 1 Neat cement 2 Cement grout **3 Bentonite** **4 Other Cement 0-2'**
 Grout Intervals From **2** ft. to **3** ft. From _____ ft. to _____ ft. From _____ ft. to _____ ft.
 What is the nearest source of possible contamination: 10 Livestock pens 14 Abandoned water well
 1 Septic tank 4 Lateral lines 7 Pit privy **11 Fuel storage** 15 Oil well/ Gas well
 2 Sewer lines 5 Cess pool 8 Sewage lagoon 12 Fertilizer storage 16 Other (specify below) _____
 3 Watertight sewer lines 6 Seepage pit 9 Feedyard 13 Insecticide storage _____
 Direction from well? _____ How many feet? _____

FROM	TO	CODE	LITHOLOGIC LOG*	FROM	TO	PLUGGING INTERVALS
0	2	CL	Clay w/silt			Flushmount waiver by D. Taylor
3	5	CL	Clay w/silt			
8	10	CL	Clay w/silt, brown/grey, mottled, moist			RECEIVED JUL 11 2006 BUREAU OF WATER
13	15	CL	Clay w/silt, dk grey, moist, soft, strong			
			*Description generalized from conditions encountered throughout the site.			

7 CONTRACTOR'S OR LANDOWNER'S CERTIFICATION: This water well was **(1)** constructed, **(2)** reconstructed, or **(3)** plugged under my jurisdiction and was completed on (mo/day/yr) **5/9/06** and this record is true to the best of my knowledge and belief. Kansas Water Well Contractor's License No. **757** This Water Well Record was completed on (mo/day/yr) **6/16/06** under the business name of **Larsen & Associates, Inc** by (signature) *[Signature]*

INSTRUCTIONS: Please fill in blanks and circle the correct answers. Send three copies to Kansas Department of Health and Environment, Bureau of Water, 1000 S W Jackson St., Ste. 420, Topeka, Kansas 66612-1367. Telephone: 913-296-5545. Send one to WATER WELL OWNER and retain one for your records.

CORRECTED

OFFICE USE ONLY

T
R

SEC