


1 LOCATION OF WATER WELL: Fraction **SW 1/4 NW 1/4 NW 1/4** Section Number **31** Township Number **T 12 S** Range Number **R 20E EW**
 County: **Douglas**

Distance and direction from nearest town or city street address of well if located within city?
817 Tennessee Street, Lawrence KS 66044. NW corner of property

2 WATER WELL OWNER: **KDHE-BER**
 RR#, St. Address, Box # : **Presto Convenience Store #25** Board of Agriculture, Division of Water Resources
 City, State, ZIP Code : **U4-023-13799** Application Number:

3 LOCATE WELL'S LOCATION WITH AN "X" IN SECTION BOX:

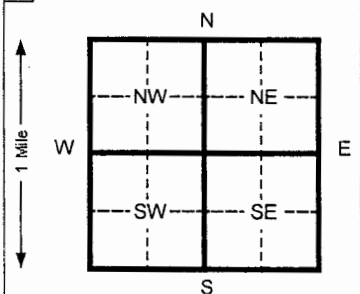

4 DEPTH OF COMPLETED WELL **20** ft. ELEVATION: **847.33 TOC**
 Depth(s) Groundwater Encountered 1 _____ ft. 2 _____ ft. 3 _____ ft.
 WELL'S STATIC WATER LEVEL **9.75** -ft. below land surface measured on mo/day/yr **6/9/05**
 Pump test data: Well water was _____ ft. after _____ hours pumping _____ gpm
 Est. Yield _____ gpm: Well water was _____ ft. after _____ hours pumping _____ gpm
 Bore Hole Diameter _____ in. to _____ ft. and _____ in. to _____ ft.
 WELL WATER TO BE USED AS: 5 Public water supply 8 Air conditioning 11 Injection well
 1 Domestic 3 Feed lot 6 Oil field water supply 9 Dewatering 12 Other (Specify below)
 2 Irrigation 4 Industrial 7 Lawn and garden (domestic) **10 Monitoring well**
 Was a chemical/bacteriological sample submitted to Department? Yes _____ No **X** If yes, mo/day/yr sample was submitted _____
 Water Well Disinfected? Yes _____ No **X**

5 TYPE OF BLANK CASING USED: 5 Wrought Iron 8 Concrete tile CASING JOINTS: Glued _____ Clamped _____
 1 Steel 3 RMP (SR) 6 Asbestos-Cement 9 Other (specify below) Welded _____
2 PVC 4 ABS 7 Fiberglass 10 Asbestos-cement Threaded **X**
 Blank casing diameter **2** in. to **20** ft., Dia _____ in. to _____ ft., Dia _____ in. to _____ ft.
 Casing height above land surface **0** in., weight _____ lbs./ft. Wall thickness or gauge No. _____

TYPE OF SCREEN OR PERFORATION MATERIAL: **7 PVC** 10 Asbestos-cement
 1 Steel 3 Stainless steel 5 Fiberglass **8 RMP (SR)** 11 Other (specify) _____
 2 Brass 4 Galvanized steel 6 Concrete tile 9 ABS 12 None used (open hole)
 SCREEN OR PERFORATION OPENINGS ARE: 5 Gauzed wrapped 8 Saw cut 11 None (open hole)
 1 Continuous slot **3 Mill slot** 6 Wire wrapped 9 Drilled holes
 2 Louvered shutter 4 Key punched 7 Torch cut 10 Other (specify) _____

SCREEN-PERFORATED INTERVALS: From **5** ft. to **20** ft. From _____ ft. to _____ ft.
 From _____ ft. to _____ ft. From _____ ft. to _____ ft.
 GRAVEL PACK INTERVALS: From **3** ft. to **20** ft. From _____ ft. to _____ ft.
 From _____ ft. to _____ ft. From _____ ft. to _____ ft.

6 GROUT MATERIAL: 1 Neat cement 2 Cement grout **3 Bentonite** **4 Other Cement 0-2'**
 Grout Intervals From **2** ft. to **3** ft. From _____ ft. to _____ ft. From _____ ft. to _____ ft.
 What is the nearest source of possible contamination:
 1 Septic tank 4 Lateral lines 7 Pit privy **10 Livestock pens** 14 Abandoned water well
 2 Sewer lines 5 Cess pool 8 Sewage lagoon **11 Fuel storage** 15 Oil well/ Gas well
 3 Watertight sewer lines 6 Seepage pit 9 Feedyard 12 Fertilizer storage 16 Other (specify below)
 13 Insecticide storage

Direction from well? _____ How many feet? _____

FROM	TO	CODE	LITHOLOGIC LOG	FROM	TO	PLUGGING INTERVALS
0	1		Asphalt overlain on brick/gravel			
	3		Clay w/some silt, brown w/ oxidation staining, soft, moist, no odor			Flushmount waiver by D. Taylor
5	8		Clay w/some silt, brown, damp, soft, no odor			
8	10		Clay w/some silt, brown, moist, soft, no odor			
	12		Clay w/some silt, dk brown, rust nodules, moist, soft, no odor			
	15		Clay w/some silt, dk brown, soft, no odor, rust nodules, v moist			
	20		Clay w/silt, brown/tan, soft, no odor, rust nodules, v moist, some grey staining			

RECEIVED
JUL 11 2006
BUREAU OF WATER

7 CONTRACTOR'S OR LANDOWNER'S CERTIFICATION: This water well was **(1)** constructed, **(2)** reconstructed, or **(3)** plugged under my jurisdiction and was completed on (mo/day/yr) **5/16/06** and this record is true to the best of my knowledge and belief. Kansas Water Well Contractor's License No. **757** This Water Well Record was completed on (mo/day/yr) **6/19/06** under the business name of **Larsen & Associates, Inc** by (signature) *Vicki Larson*

INSTRUCTIONS: Please fill in blanks and circle the correct answers. Send three copies to Kansas Department of Health and Environment, Bureau of Water, 1000 S W Jackson St., Ste. 420, Topeka, Kansas 66612-1367. Telephone: 913-296-5545. Send one to WATER WELL OWNER and retain one for your records.