


1 LOCATION OF WATER WELL: Fraction Section Number Township Number Range Number
 County: Douglas NE W 1/2 W 1/2 29 12 5 20 017

Distance and direction from nearest town or city street address of well if located within city? 720 Grant Street Lawrence, Kansas 66604

2 WATER WELL OWNER: City of Lawrence, Kansas
 RR #, St. Address, Box #: 6 E. 6th St.; P.O. Box 708
 City, State, ZIP Code: Lawrence, KS. 66044-0708
 Board of Agriculture, Division of Water Resources
 Application Number: _____

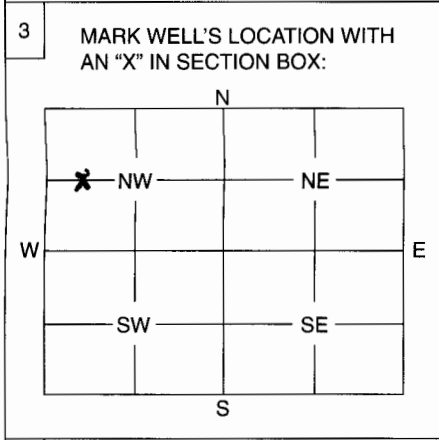

4 DEPTH OF WELL 54 ft.
 WELL'S STATIC WATER LEVEL 19.5 ft.
 WELL WAS USED AS:
 1 Domestic 5 Public Water Supply 9 Dewatering
 2 Irrigation 6 Oil Field Water Supply 10 Monitoring Well
 3 Feedlot 7 Domestic (Lawn & Garden) 11 Injection Well
 4 Industrial 8 Air Conditioning 12 Other

Was a chemical / bacteriological sample submitted to Department? Yes No X.....
 If yes, mo/day/yr sample was submitted

Water Well Disinfected: Yes X No

5 TYPE OF BLANK CASING USED:
 1 Steel 3 RMP (SR) 5 Wrought 7 Fiberglass 9 Other (Specify below)
2 PVC 4 ABS 6 Asbestos-Cement 8 Concrete Tile

Blank casing diameter 12 in. Was casing pulled? Yes X No If yes, how much All of it

Casing height above or below land surface (pulled) in.

6 GROUT PLUG MATERIAL: 1 Neat cement 2 Cement grout 3 Bentonite 4 Other Soil, Cuttings @ the surface
 Grout Plug Intervals: From 10 ft. to 1 ft., From 1 ft. to 0 ft., From to

What is the nearest source of possible contamination:
 1 Septic tank 6 Seepage pit 11 Fuel storage 16 Other (specify below)
 2 Sewer lines 7 Pit privy 12 Fertilizer storage

3 Watertight sewer lines 8 Sewage lagoon 13 Insecticide storage
 4 Lateral lines 9 Feedyard 14 Abandoned water well
 5 Cess pool 10 Livestock pens 15 Oil well/Gas well

Direction from well? East How many feet? ~150'

FROM	TO	PLUGGING MATERIALS
<u>10'</u>	<u>1'</u>	<u>Cement Grout</u>
<u>1'</u>	<u>0'</u>	<u>Soil</u>
<u>0'</u>	<u>8" above surface</u>	<u>8" Concrete lining</u>

* Well screen: Casing were pulled out of the ground. Native materials collapsed to within 10' of ground surface where grouting materials were placed to the surface.

7 CONTRACTOR'S OF LANDOWNER'S CERTIFICATION: This water well was plugged under my jurisdiction and was completed on (mo/day/year) 5/3/07 and this record is true to the best of my knowledge and belief. Kansas Water Well Contractor's License No. 509 This Water Well Record was completed on (mo/day/year) 5/17/07 under the business name of Griffin Dewatering, North Central, LLC by (signature) Josh Lamborgh

INSTRUCTIONS: Use typewriter or ball point pen. Please press firmly and print clearly. Please fill in blanks, underline or circle the correct answers. Send top three copies to Kansas Department of Health and Environment, Bureau of Water, Geology Section, 1000 SW Jackson St., Ste. 420, Topeka, Kansas 66612-1367. Telephone: 785/296-5522. Send one to Water Well Owner and retain one for your records.