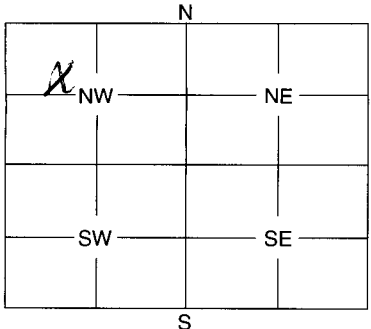


1 LOCATION OF WATER WELL: Fraction (KGS) NE NE NE NW
 County: Douglas (per address) N 1/4 N 1/4 NW 1/4 Section Number 30 Township Number 12 5 Range Number 20 EN

Distance and direction from nearest town or city street address of well if located within city?
3rd & North Streets Lawrence KS.

2 WATER WELL OWNER: CITY OF LAWRENCE KS.
 RR #, St. Address, Box #: 6 E. 6th ST PO. Box 708
 City, State, ZIP Code: LAWRENCE KS. 66044-0708
 Board of Agriculture, Division of Water Resources Application Number: _____

3 MARK WELL'S LOCATION WITH AN "X" IN SECTION BOX:


4 DEPTH OF WELL 46 ft.
 WELL'S STATIC WATER LEVEL 8 ft.
 WELL WAS USED AS:
 1 Domestic 5 Public Water Supply 9 Dewatering
 2 Irrigation 6 Oil Field Water Supply 10 Monitoring Well
 3 Feedlot 7 Domestic (Lawn & Garden) 11 Injection Well
 4 Industrial 8 Air Conditioning 12 Other

Was a chemical / bacteriological sample submitted to Department? Yes _____ No X
 If yes, mo/day/yr sample was submitted _____
 Water Well Disinfected: Yes X No _____

5 TYPE OF BLANK CASING USED:
 1 Steel 3 RMP (SR) 5 Wrought 7 Fiberglass 9 Other (Specify below) _____
 2 PVC 4 ABS 6 Asbestos-Cement 8 Concrete Tile

Blank casing diameter 12 in. Was casing pulled? Yes X No _____ If yes, how much All of it
 Casing height above or below land surface (pulled) in.

6 GROUT PLUG MATERIAL: 1 Neat cement 2 Cement grout 3 Bentonite 4 Other Soily Cuttings @ the surface
 Grout Plug Intervals: From 8 ft. to 3 ft., From 3 ft. to 0 ft., From _____ to _____ ft.

What is the nearest source of possible contamination:
 1 Septic tank 6 Seepage pit 11 Fuel storage 16 Other (specify below) _____
 2 Sewer lines 7 Pit privy 12 Fertilizer storage
 3 Watertight sewer lines 8 Sewage lagoon 13 Insecticide storage
 4 Lateral lines 9 Feedyard 14 Abandoned water well
 5 Cess pool 10 Livestock pens 15 Oil well/Gas well

Direction from well? _____ How many feet? _____

FROM	TO	PLUGGING MATERIALS
8'	3'	Concrete Grout
3'	Surface	Native Clay, Drill Cuttings
0'	8" above surface	8" Concrete paving

* Well screen and Casing were pulled out of the ground. Native materials collapsed to within 8' of ground surface where concrete grout was placed to 3' below grade and clay / topsoil to the surface.

7 CONTRACTOR'S OF LANDOWNER'S CERTIFICATION: This water well was plugged under my jurisdiction and was completed on (mo/day/year) 2/28/07 and this record is true to the best of my knowledge and belief. Kansas Water Well Contractor's License No. 509 This Water Well Record was completed on (mo/day/year) 5/1/07 under the business name of Geo. Fin. Dewatering, North Central, LLC by (signature) Jack L. Umbrough

INSTRUCTIONS: Use typewriter or ball point pen. Please press firmly and print clearly. Please fill in blanks, underline or circle the correct answers. Send top three copies to Kansas Department of Health and Environment, Bureau of Water, Geology Section, 1000 SW Jackson St., Ste. 420, Topeka, Kansas 66612-1367. Telephone: 785/296-5522. Send one to Water Well Owner and retain one for your records.