

(West well)

**CORRECTION(S) TO WATER WELL RECORD (WWC-5)**

(to rectify lacking or incorrect information)

County: Douglas

Location listed as:

Location changed to:

Section-Township-Range: 17-12 South

17-12-20 E

Fraction (  $\frac{1}{4}$   $\frac{1}{4}$   $\frac{1}{4}$ ): SW NW SE

NW NW SE SW

Other changes: Initial statements: \_\_\_\_\_

Changed to: Location of well: Lawrence Airport, South of  
Terminal, then West past hangars.

Comments: footages listed appear incorrect; 1304 FSL, 3777 FEL per  
LED. used datum WGS 84

verification method: Latitude, Longitude and location description  
of constructed well. KGS LED & Google Earth.

initials: DS date: 7/22/2010

submitted by: Kansas Geological Survey, Data Resources Library, 1930 Constant Ave., Lawrence, KS 66047-3726

to: Kansas Dept of Health & Environment, Bureau of Water, 1000 SW Jackson, Suite 420, Topeka, KS 66612-1367.

# WATER WELL PLUGGING RECORD Form WWC-5P

KSA 82a-1212

ID NO.

West Well

|   |  |                      |                           |  |
|---|--|----------------------|---------------------------|--|
| <b>1 LOCATION OF WATER WELL:</b><br>County: Douglas | Fraction<br><u>SW</u> <u>1/4</u> <u>NW</u> <u>1/4</u> <u>SE</u> <u>1/4</u> | Section Number<br>17 | Township Number<br>T 12 S | Range Number<br><input checked="" type="checkbox"/> E <input type="checkbox"/> W |
|---|--|----------------------|---------------------------|--|

Street/Rural Address of Well Location; if unknown, distance & direction from nearest town or intersection: If at owner's address, check here ☐ 1780' N, 5020' W from SE corner

## Global Positioning Systems (GPS) information:

Latitude: 39 degrees, 0', 14.9" N (in decimal degrees)

Longitude: 95 degrees, 13', 7.6" W (in decimal degrees)

Elevation:

Datum: ☐ WGS84, ☐ NAD83, ☐ NAD27

## Collection Method:


☐ GPS unit (Make/Model: \_\_\_\_\_)

☐ Digital Map/Photo, ☐ Topographic Map, ☐ Land Survey

Est. Accuracy: ☐ < 3 m, ☐ 3-5 m, ☐ 5-15 m, ☐ > 15 m

**2 WATER WELL OWNER:** Lawrence Utilities Dept.  
RR#, St. Address, Box #: 6 E. 6th Street  
City, State ZIP Code: Lawrence, KS 66044

## 3 MARK WELL'S LOCATION WITH AN "X" IN SECTION BOX:

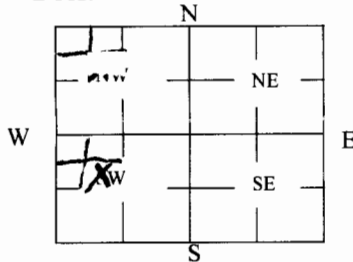

## 4 DEPTH OF WELL 80 ft.

WELL'S STATIC WATER LEVEL 17 ft

WELL WAS USED AS:

☐ Domestic  
☐ Irrigation  
☐ Feedlot  
☐ Industrial

☐ Public Water Supply  
☐ Oil Field Water Supply  
☐ Domestic (Lawn & Garden)  
☐ Air Conditioning

☐ Dewatering  
☐ Monitoring  
☐ Injection Well  
☒ Other fire protect

Was a chemical/bacteriological sample submitted to Department? Yes ☐ No ☒

## 5 TYPE OF BLANK CASING USED:

☒ Steel  
☐ PVC

☐ RMP (SR)  
☐ ABS

☐ Wrought  
☐ Asbestos-Cement

☐ Fiberglass  
☐ Concrete Tile

☐ Other (Specify below) \_\_\_\_\_

Blank casing diameter 18 in. Was casing pulled? Yes ☐ No ☒ If yes, how much \_\_\_\_\_  
Casing height above or below land surface 24 in.

## 6 GROUT PLUG MATERIAL: ☐ Neat cement ☒ Cement grout ☒ Bentonite ☒ Other Chlorinated sand

Grout Plug Intervals: From 80 ft. to 17 ft., From 17 ft. to 15 ft., From 15 to 4 ft.

What is the nearest source of possible contamination:

☐ Septic tank  
☐ Sewer lines  
☐ Watertight sewer lines  
☐ Lateral lines  
☐ Cess pool

☐ Seepage pit  
☐ Pit privy  
☐ Sewage lagoon  
☐ Feedyard  
☐ Livestock pens

☐ Fuel Storage  
☐ Fertilizer storage  
☐ Insecticide storage  
☐ Abandoned water well  
☐ Oil well/Gas well

☒ Other (specify below)  
airport runway

Direction from well? \_\_\_\_\_

How many feet? \_\_\_\_\_

| FROM | TO | PLUGGING MATERIALS  | FROM | TO | PLUGGING MATERIALS |
|------|----|---------------------|------|----|--------------------|
| 80   | 17 | Chlorinated sand    |      |    |                    |
| 17   | 15 | Bentonite chips     |      |    |                    |
| 15   | 4  | 8-sack cement grout |      |    |                    |
|      |    |                     |      |    |                    |
|      |    |                     |      |    |                    |
|      |    |                     |      |    |                    |
|      |    |                     |      |    |                    |

**Original Returned to Sender**

**for Correction Date: 6/21/10**

**7 CONTRACTOR'S OR LANDOWNER'S CERTIFICATION:** This water well was plugged under my jurisdiction and was completed on (mo/day/year) 5/26/10 and this record is true to the best of my knowledge and belief. Kansas Water Well Contractor's License No. 102. This Water Well Record was completed on (mo/day/year) 6/14/10 under the business name of Layne Christensen Company by (signature) [Signature]

**INSTRUCTIONS:** Use typewriter or ballpoint pen. Please press firmly and print clearly. Please fill in blanks, underline or circle the correct answers. Send top three copies to Kansas Department of Health and Environment, Bureau of Water, Geology Section, 1000 SW Jackson St., Ste. 420, Topeka, Kansas 66612-1367. Telephone: 785/296-5524. Send one to Water Well Owner and retain one for your records. Visit us at <http://www.kdheks.gov/waterwell/index.html>.

Check one:

☒ White Copy ☐ Blue Copy ☐ Pink Copy