

## Division of Water Resources App. No.

KSA 82a-1212




# PATCHEN

ELECTRIC & INDUSTRIAL SUPPLY, INC.

SINCE 1948

PUMP & WELL DRILLING SERVICE, INC.

P.O. BOX 1060, 602 E. 9th LAWRENCE, KANSAS 66044, (913) 843-4522 FAX (913) 843-4528

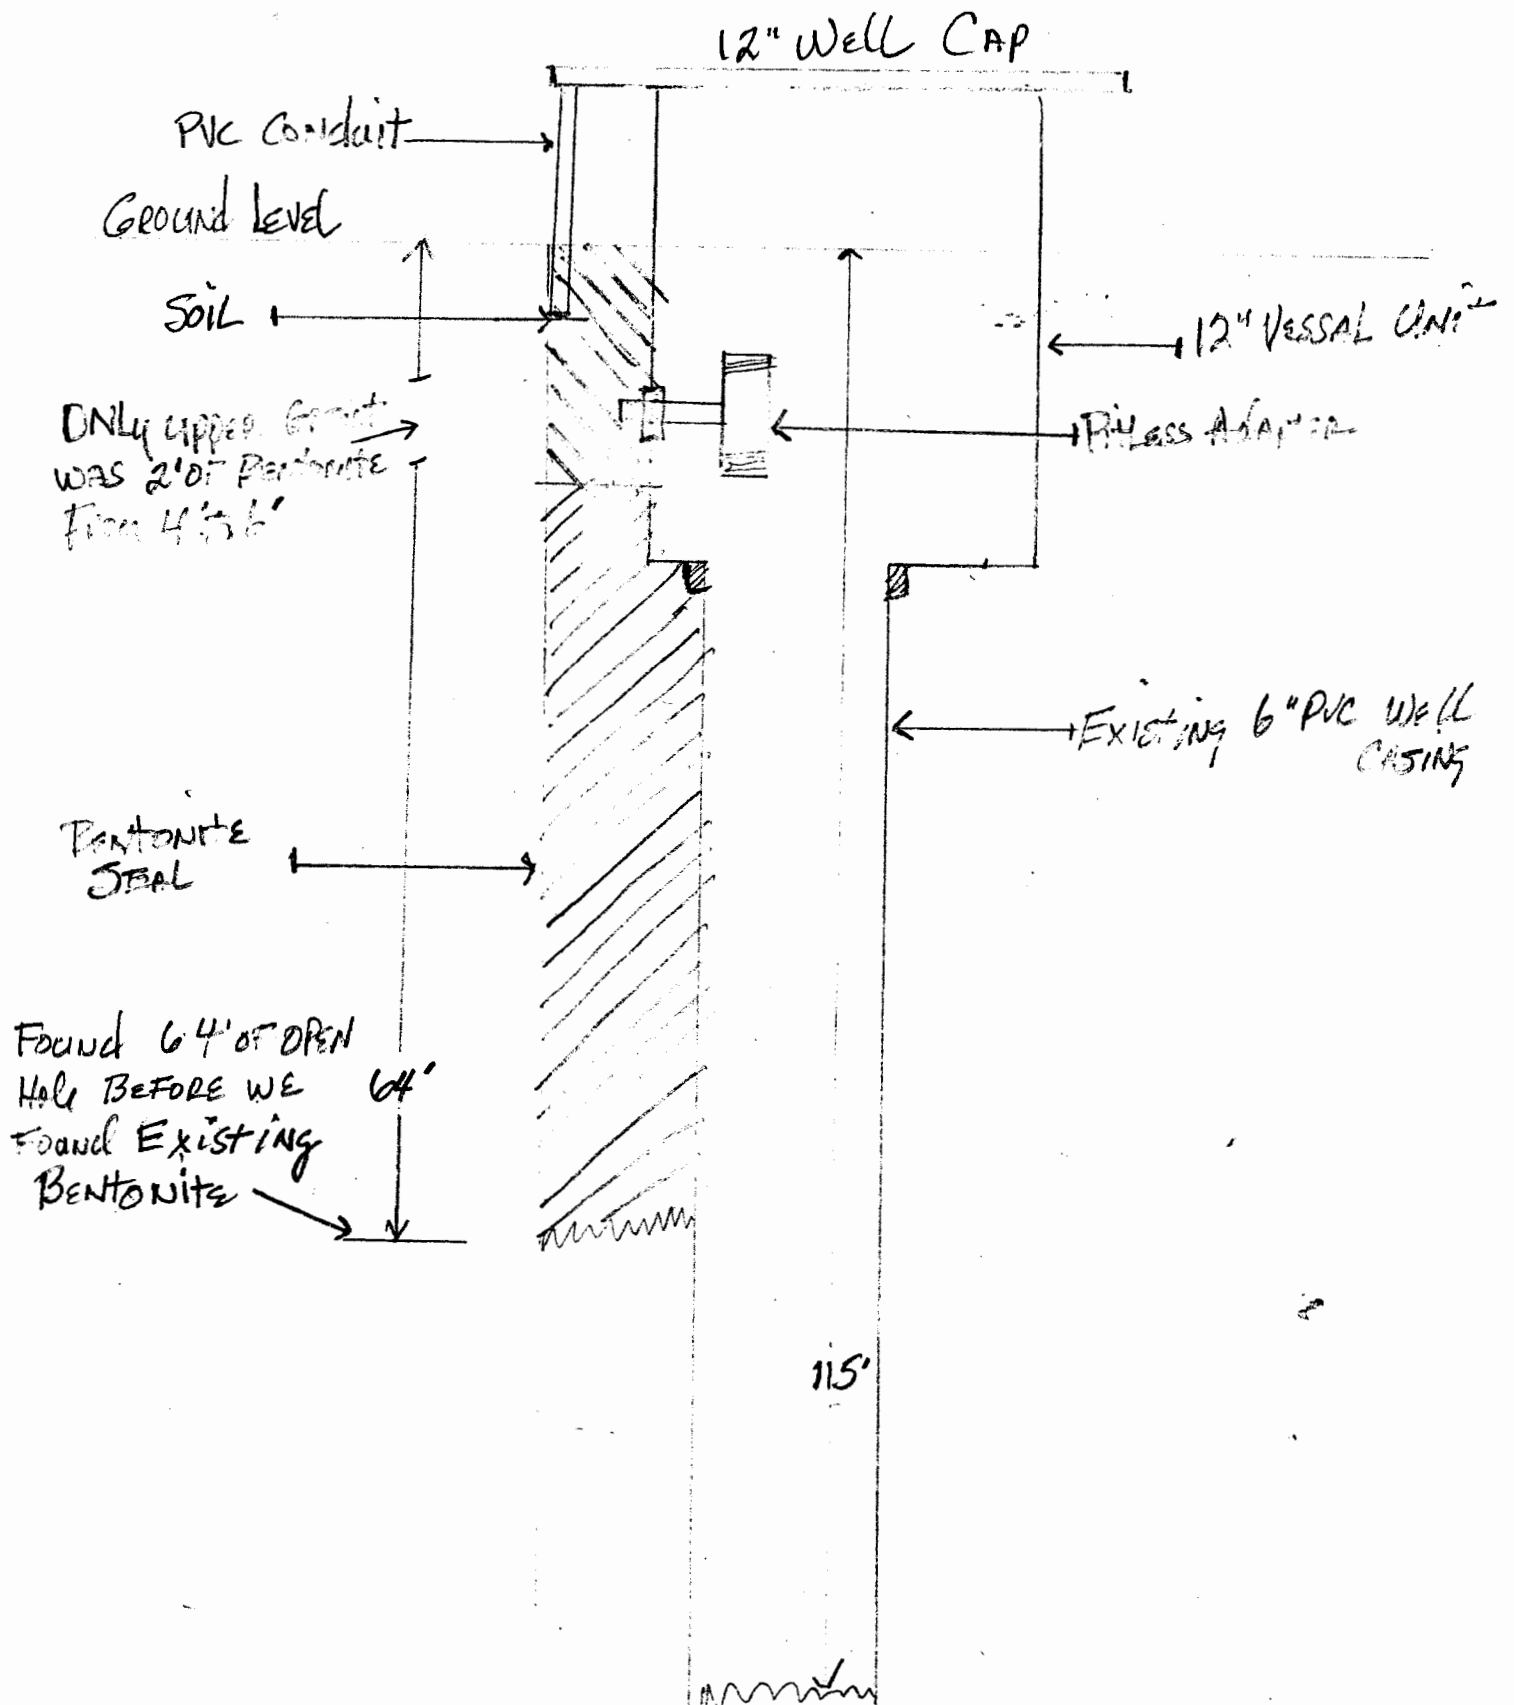

1/1

New Message

(785)865-6515 to patchen1948@sbcglobal.net  
Received: Apr 13, 2012  
Expires in 60 days





1 / 1

New Message

(785)865-6515 to patchen1948@sbcglobal.net  
Received: Apr 13, 2012  
Expires in 60 days

