


1 LOCATION OF WATER WELL: County: <u>Douglas</u>	Fraction <u>1/4 SW 1/4 SW 1/4</u>	Section Number <u>34</u>	Township Number <u>12</u>	Range Number <u>20</u> EW
--	--------------------------------------	-----------------------------	------------------------------	--

Distance and direction from nearest town or city street address of well if located within city?

2 WATER WELL OWNER: <u>Nancy Schwalling</u> RR#, St. Address, Box #: <u>1706 N 1500 Rd</u> City, State ZIP Code: <u>Lawrence Ks.</u>	Global Positioning Systems (decimal degrees, min. of 4 digits) Latitude: <u>38 57 28.14</u> Longitude: <u>95 11 05.84</u> Elevation: <u>826</u> Datum: _____ Data Collection Method: <u>Google</u>
---	--

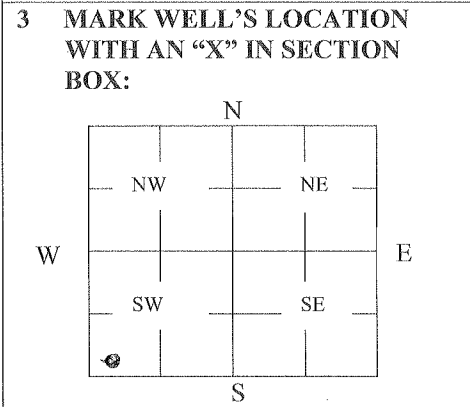

4 DEPTH OF WELL 27' ft.

WELL'S STATIC WATER LEVEL Dry ft

WELL WAS USED AS:

<input checked="" type="radio"/> Domestic	5 Public Water Supply	9 Dewatering
2 Irrigation	6 Oil Field Water Supply	10 Monitoring
3 Feedlot	7 Domestic (Lawn & Garden)	11 Injection Well
4 Industrial	8 Air Conditioning	12 Other _____

Was a chemical/bacteriological sample submitted to Department? Yes _____ No

5 TYPE OF BLANK CASING USED:

1 Steel	3 RMP (SR)	5 Wrought	7 Fiberglass	9 Other (Specify below)
2 PVC	4 ABS	6 Asbestos-Cement	8 Concrete Tile	<u>Sand point</u>

Blank casing diameter 2" in. Was casing pulled? Yes No _____ If yes, how much All (27')

Casing height above or below land surface _____ in.

6 GROUT PLUG MATERIAL:

1 Neat cement	2 Cement grout	<input checked="" type="radio"/> Bentonite	4 Other <u>concrete</u>
---------------	----------------	--	-------------------------

Grout Plug Intervals: From 27' ft. to 1' ft., From 1' ft. to 0 ft., From _____ to _____ ft.

What is the nearest source of possible contamination:

1 Septic tank	6 Seepage pit	11 Fuel Storage	<input checked="" type="radio"/> Other (specify below)
2 Sewer lines	7 Pit privy	12 Fertilizer storage	<u>Farm Fields</u>
3 Watertight sewer lines	8 Sewage lagoon	13 Insecticide storage	
4 Lateral lines	9 Feedyard	14 Abandoned water well	Direction from well? <u>North / East</u>
5 Cess pool	10 Livestock pens	15 Oil well/Gas well	How many feet? <u>20'</u>

FROM	TO	PLUGGING MATERIALS	FROM	TO	PLUGGING MATERIALS
		<u>sand point well in pit</u>			
		<u>sand point was pulled out to 27' (TD)</u>			
		<u>Bentonite from 27'-1'</u>			
		<u>concrete from 1'-0'</u>			

7 CONTRACTOR'S OR LANDOWNER'S CERTIFICATION: This water well was plugged under my jurisdiction and was completed on (mo/day/year) 8/4/14 and this record is true to the best of my knowledge and belief. Kansas Water Well Contractor's License No. 732. This Water Well Record was completed on (mo/day/year) 9/18/14 under the business name of GB Environmental Drilling by (signature) James Baker

INSTRUCTIONS: Use typewriter or ballpoint pen. Please press firmly and print clearly. Please fill in blanks, underline or circle the correct answers. Send top three copies to Kansas Department of Health and Environment, Bureau of Water, Geology Section, 1000 SW Jackson St., Ste. 420, Topeka, Kansas 66612-1367. Telephone: 785/296-5522. Send one to Water Well Owner and retain one for your records. Visit us at <http://www.kdheks.gov/geo/waterwells>.