County: _	Douglas	Fraction:	NW SE NW	SE	Sec	33	т	12	_s	R	20	<u> </u>
CORREC	CTION(S) to WATER WEI	LL COMPLE	TION RECORD	Forn	n WWC	<b>-5</b> (to	rectify	lacking	g or i	ncorr	ect infor	nation)
Owner:	Public Wholesale Wat	er Dist. 25										B 1
If location corrected, was listed as:					Locat	ion cha	nged to	:				
Section-To	ownship-Range:											
Fraction (¼ calls):							NW	SEN	W	SE		
	anges: Initial statements:											
Changed to	0:	··· ··										
Comments: This record is part of a series of water well records with incomplete fractions.												
	PS coordinates provid	ed do not s	pecify the dat	um u	sed.							
Verificatio	on method: Typed GPS	coordinate	es in to KGS L	EOW	/EB sc	oftware	e. Use	d all	datı	um N	NAD 27	7,
NAD 83	3, and WGS 84 when	entering co	ordinates in to	LEC	WEB,	which	n all re	esulte	ed in	the	same	
section	-township-range and f	ractions.				Initials:	SW	E	Date:	07-	26-201	9
Submitted	by: E Kansas Geological Kansas Dept. of He		esources Library,	1930 (	Constant	Ave., L	.awrenc	e, KS (	6604	7-372	4	

(rev 01/26/2018)

<b>XX/A</b>	TER WE	TLDF	COBD	Form	n WWC-5	n	ivision of Wate	r Resources App. No	B1		
			TER WELL:	Fraction	1 H H C-J		ion Number	Township No.	Range N	lumber	
	County: Do		TER WELL.	14 4	1/4 1/	4	33		R 20	ZE DW	
			f Well Location								
	Street/Rural Address of Well Location; if unknown, distance & direction from nearest town or intersection: If at owner's address, check here									imal degrees)	
	nom neares		increased on. If at t	When 5 address, v			.577W				
						Elev	ation:				
						- Datu	m: 🔲 WGS 84	4, 🗌 NAD 83, 🗌	NAD 27		
2	2 WATER WELL OWNER: Public Wholesale Water Dist. #25 Collection Method:										
	RR#, Street Address, Box #:       946 E. 650th Road       GPS unit (Make/Model:)         City, State, ZIP Code       :       I awrence, KS 66047       Digital Map/Photo, Dopographic Map, Land Survey										
	City, State,	ZIP Code	: Lawrend	ze, KS 66047			Digital Map/Ph	oto, 🗌 Topographic	: Map, 🛄	Land Survey	
<u> </u>	Image: Source well         Image:										
				OMDI ETED V	VELT 53'5"		Ð				
	WITH AN "X" IN SECTION BOX:4 DEPTH OF COMPLETED WELL .53'5"ft.Depth(s) Groundwater Encountered (1) ft.(2) ft.(3) ft.										
	N WELL'S STATIC WATER LEVEL										
1 .	Pump test data: Well water was. 34ft. after. 24 hours pumping. 302 gpm										
	EST VIELD and Well water was fafter hours numping and										
w		E		TO BE USED A					njection w	ell	
		•	Domestic					watering C			
	sw	SE						nitoring well			
[			Was a chemical/	bacteriological sa	mple submitted	to Denar	tment?	Yes I No			
	S			day/yr sample wa							
1 1-	1 mile-			fected? $\Box$ Yes		••••••					
L											
			ISED: 🗹 Steel		Other		•••••••	••••			
CA	SING JOIN		Glued Clam	ped U Welde	d V Threade	bd		•	•	•	
	asing diam	eter .1.2	in. to . 22	ft., Diamet	er in	. to	ft., D		in. to	π.	
			nd surface		eight	lbs./1	tt., Wall thic	kness or gauge No	)		
TY			PERFORATION		г		Const. Const.				
	Steel Brass		inless Steel vanized Steel	Dev PVC			specity)	••••••	•••••		
l sc			TION OPENING		pen noie)						
J SC					1 🔲 Torch cut	🗖 Dr	illed holes	None (open hole	6		
		ed shutter	Key nunched	Wire wrapped	Saw cut		her (specify)				
SC	REEN-PER	FORATE	D INTERVALS:	From	ft. to53'2		ft., From	ft. t	0	ft.	
				From	ft. to		ft., From	ft. t	o	ft.	
	GRAV	VEL PACE	K INTERVALS:	From	ft. to		ft., From	ft. t	o	ft.	
								ft. t			
6 G	<b>GROUT MA</b>	ATERIAL	: 🗹 Neat ceme	nt 🗌 Cement g	grout 🔲 Bento	onite [	] Other				
Gro	ut Intervals:	: From	.22 ft. to		From	. ft. to	ft.,	From	ft. to	ft.	
What			e of possible conta								
			Lateral line					storage Othe	er (specify l	below)	
	Sewer l				on 🔲 Fuel stora	ge	Abandoned				
			ines 🔲 Seepage pi		Fertilizer :		Oil well/ga			•••••	
		om well	LITUOLOG	(a) 00							
FRO	<u>ом то</u>		LITHOLOG	IC LOG	FROM	TO	LITHO. LC	OG (cont.) <u>or</u> PLU	GOINGI	NIERVALS	
		See att	ached								
		+						A 817			
			·.								
7 C	ONTRACT	OR'S OF	R LANDOWNER	'S CERTIFICA'	TION: This wa	ter well v	was 🔽 constru	icted, 🗌 reconstru	icted, or	plugged	
und	er my jurisd	liction and	was completed or	(mo/day/year) .	5/9/2018a	nd this r	ecord is true to	o the best of my ki	nowledge	and belief.	
Kan	sas Water V	Vell Contr	actor's License No	793 T	his Water Well I	Record v	vas completed	on (mo/dav/vear)	£/9/2018	·····	
und	er the husin	ess name o	of Cahoy Pump	Service		by (s	signature) 🛠	wang car	<u>m/</u>		
INST	<b>TRUCTIONS</b>	<ul> <li>Lise ty new</li> </ul>	riter or ball noint nen	PLEASE PRESS FL	RMLY and PRINT c	leariy. Ple	ease fill in blanks	and check the correct	answers. S	end three copies	
(whit	te, blue, pink)	to Kansas D	epar tment of Health a d one copy to WAT	and E nvironment, Bu	and retain one for	logy Secti	on, 1000 SW Jac rds Include fee	of \$5.00 for each cor	opeka, Kan	ell. Vi sit us at	
	//www.kdheks			IN TIDLE OWNER	and reading the rol	,001 1000					

COPY



## CAHOY PUMP SERVICE

SUMNER, IA Corporate Office 563-578-1130 MARNE, IA 712-781-2030

## DRILLER'S LOG

CLIENT: Kansas PWWSD #25

WELL: B-1

**DATE STARTED: 3/8/2018** 

DATE COMPLETED: 3/9/2018

DRILLER/LIC.#: 793

**County:** Douglas

GPS: 38<sup>0</sup> 57.735N 95<sup>0</sup> 11.577W


\_\_\_\_ mi N/S and \_\_\_\_ mi E/W of intersection of \_\_\_\_\_\_ and \_\_\_\_\_\_ \_\_\_\_ ¼ of the \_\_\_\_\_ ¼ of the \_\_\_\_\_ ¼ of \_\_\_\_\_ Sec \_\_\_\_\_ TWP \_\_\_\_\_\_RNG \_\_\_\_\_ E/W

ROD#	LENGTH	DEPTH	FORMATION DESCRIPTION	DEPTH STARTED	DEPTH ENDED
24" drag	5' 6"	5' 6"	Silty brown clay	0'	12.0'
Kelly	22' 6"	28.0'	Fine brown sand "tight"	12.0′	15.0′
1 <sup>st</sup> rod	21.0′	49.0'	Fine to med rustd brown	15.0'	22.5'
2 <sup>nd</sup> rod	10' 6"	59' 6"	Sand w/clay streak from 15.5'-18'		
			Med rusty sand	22.5'	35.0'
		•	Few clay streaks from 31'-34'		
			Med to coarse gray sand	35.0′	38.0'
			Fine to med uniform gray sand	38.0′	44.5'
Screen casing			Med gray sand & gravel	44.5'	45.0'
Screen (SS)	20' 11"		Med to coarse gray sand w/pebbles	45.0'	53.5'
Casing Certilok	20.0'		Med to coarse gray sand w/pebbles	45.0'	53.51'
Casing Certilok	20.0'		Limestone-drilling	53.5'	
Total	60' 11"		Ceased		

Form revised 7/11/2017

## CAHOY WELL AND PUMP SERVICE 24568 150<sup>TH</sup> ST. STE. 200 SUMNER, IA 50674

OWNER: Kansas PWWSD #25 WELL: B-1 DATE: 3/9/2018 GPS: 38<sup>o</sup> 57.735N 95<sup>o</sup> 11.577W 563-578-1130 SUMNER, IA 563-578-1135 FAX 712-781-2030 MARNE, IA 712-781-2032 FAX

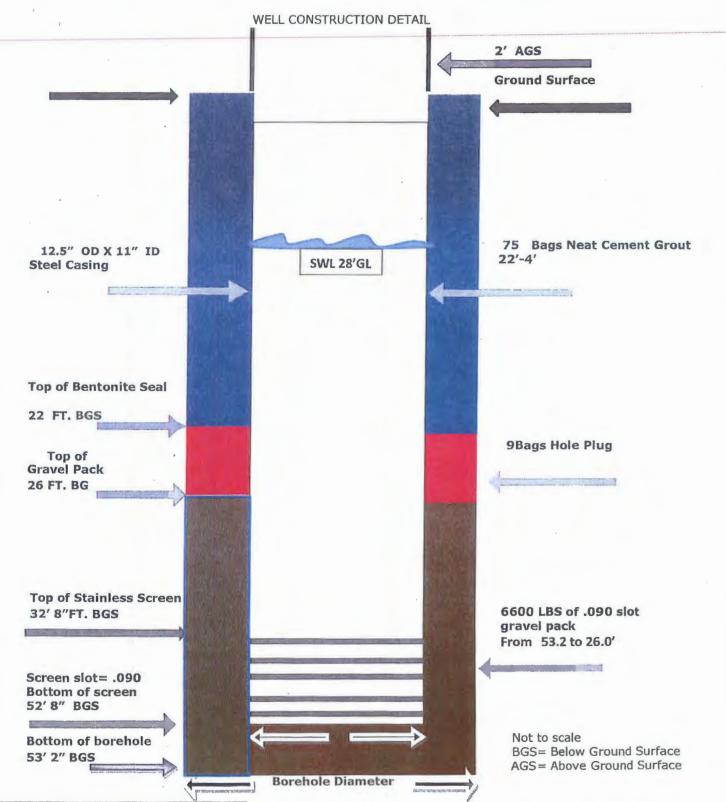

24"