

COPY



CAHOY PUMP SERVICE

SUMNER, IA
Corporate Office
563-578-1130

MARNE, IA
712-781-2030

DRILLER'S LOG

CLIENT: Kansas PWWSD #25

WELL: B2

DATE STARTED: 2/20/2018

DATE COMPLETED: 2/20/2018

DRILLER/LIC.#: 793

County: Douglas

GPS: 38° 57.739M 95° 10.659W

___ mi N/S and ___ mi E/W of intersection of _____ and _____


___ ¼ of the ___ ¼ of the ___ ¼ of ___ Sec _____ TWP _____ RNG ___ E/W

ROD#	LENGTH	DEPTH	FORMATION DESCRIPTION	DEPTH STARTED	DEPTH ENDED
Bit	5' 10"	5' 10"	Top soil	0'	1'
Kelly	22' 8"	28' 6"	Fine sand	1'	10'
1 st rod	21'	49' 6"	Fine to medium brown sand	10'	19'
2 nd rod	10' 6"	60'	Medium to coarse rusty sand	20'	24'
			Medium to rusty sand	24'	27'
			Medium to coarse rusty sand	27'	31.5'
			Medium gray sand	31.5'	47'
Screen casing			Gray clay streak from 35.5' to 37'		
Screen SS 20' 11"			Green clay streaks @ 44' & 47'		
Casing Certilok 20'					
Casing Certilok 20'			Medium gray/brown sand w/pebbles	47'	53.4'
Total=60' 11"			Cemented layer @ 50.5'		
			Drilling ceased	53.4'	

CAHOY WELL AND PUMP SERVICE
 24568 150TH ST. STE. 200
 SUMNER, IA 50674

OWNER: Kansas PWWSD #25
 WELL: B2
 DATE: 02/20/2018
 GPS: 38° 57.739N 95.10659W

563-578-1130 SUMNER, IA
 563-578-1135 FAX
 712-781-2030 MARNE, IA
 712-781-2032 FAX

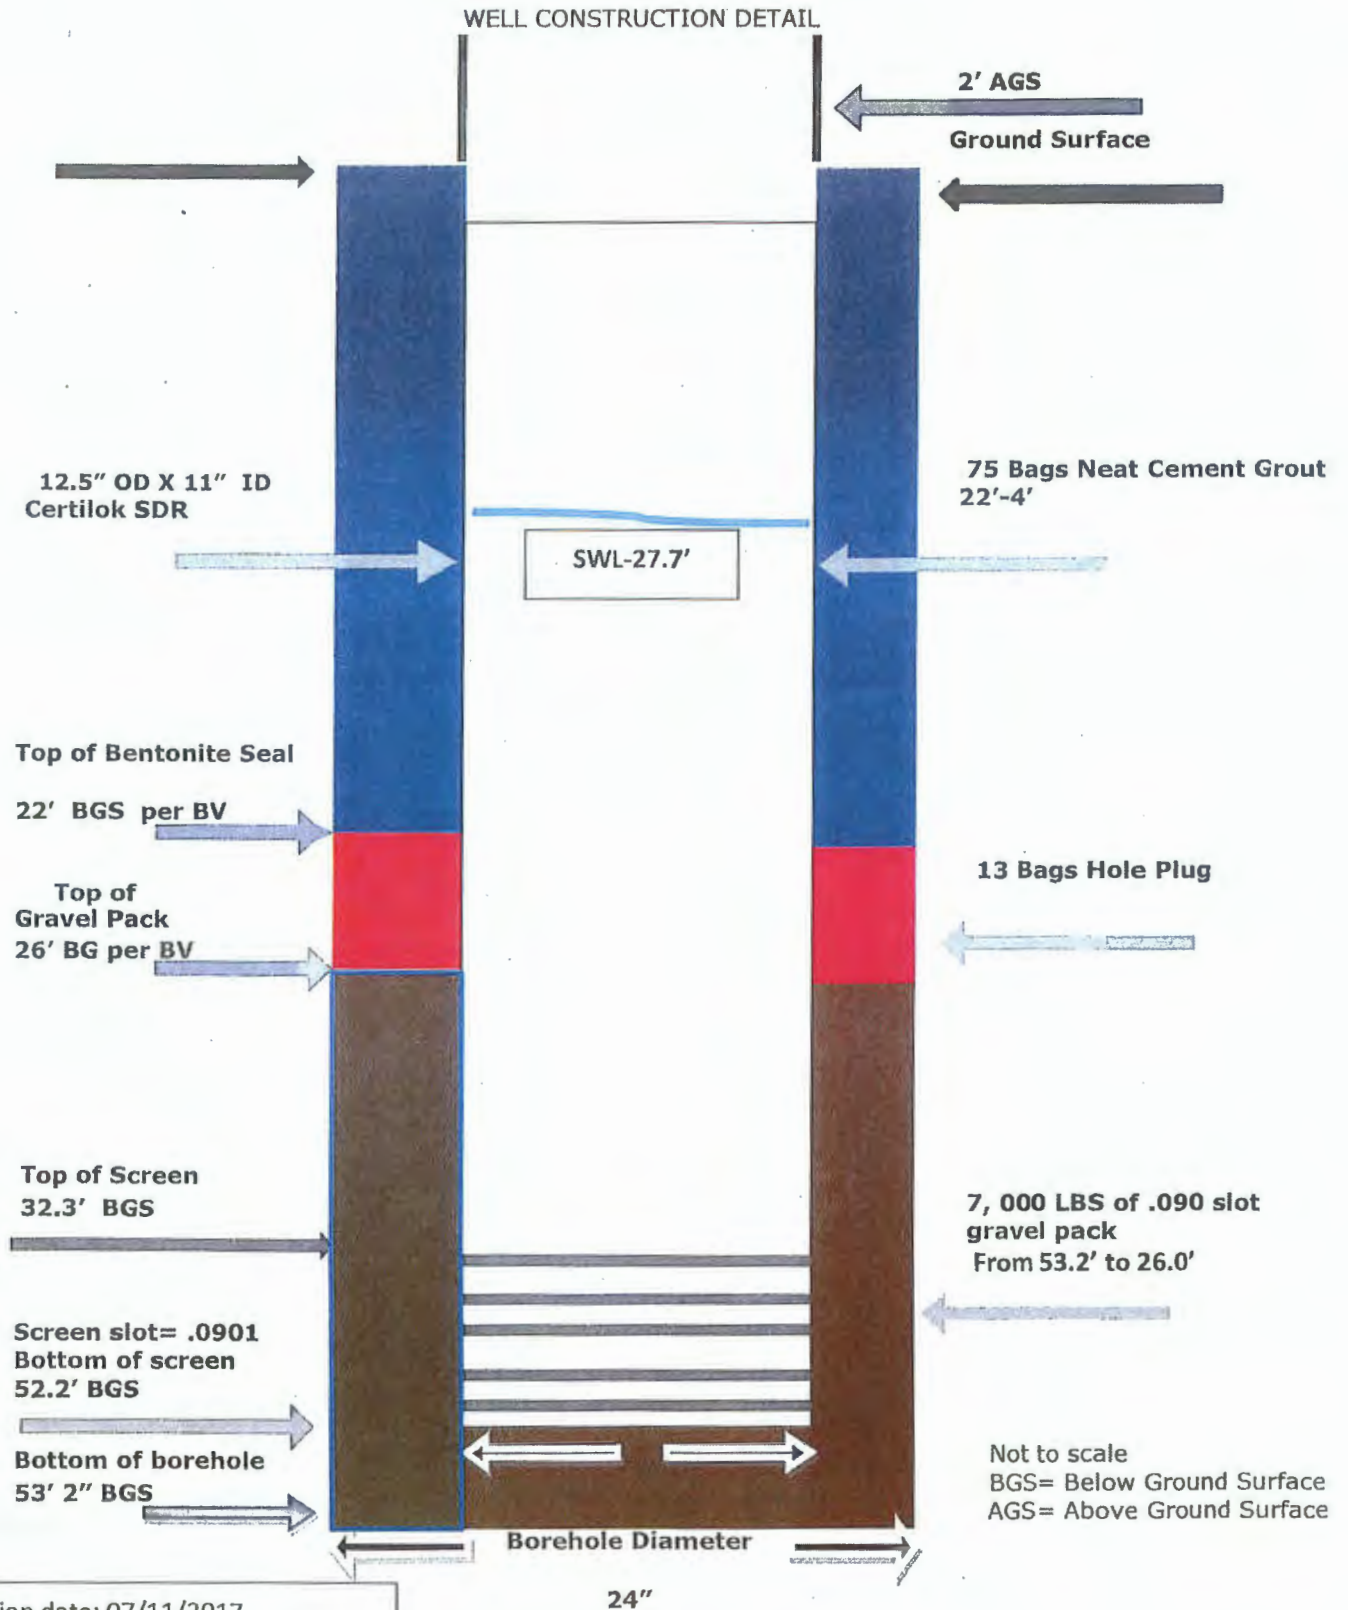

Revision date: 07/11/2017