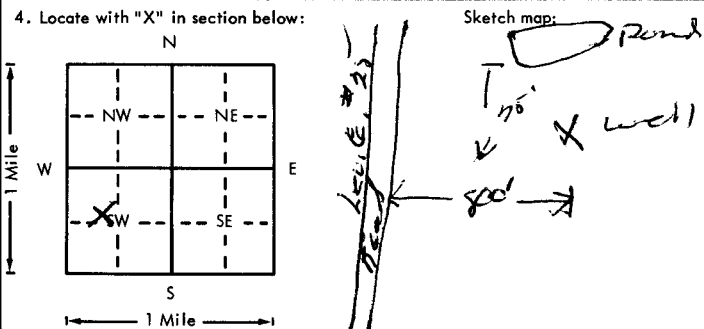


USE TYPEWRITER OR BALL POINT PEN-PRESS FIRMLY, PRINT CLEARLY.

WATER WELL RECORD
KSA 82a-1201-1215

Kansas Department of Health and Environment-Division of Environment
(Water well Contractors)
Topeka, Kansas 66620

133

1. Location of well: County <u>Leavenworth</u> Fraction <u>SE 1/4 SW 1/4 SW 1/4</u> Section number <u>11</u> Township number <u>T 12 S</u> Range number <u>R 21</u> E/W	
2. Distance and direction from nearest town or city: <u>1 W 1 1/2 N</u> Street address of well location if in city: <u>Linwood</u>	
3. Owner of well: <u>John Methica</u> R.R. or street: <u>RR # 1, Box 94A</u> City, state, zip code: <u>Linwood, Ks, 66052</u>	
4. Locate with "X" in section below: 	
5. Type and color of material	
<table border="1" style="width:100%; border-collapse: collapse;"> <thead> <tr> <th></th> <th>From</th> <th>To</th> <th>From</th> <th>To</th> </tr> </thead> <tbody> <tr> <td>Red Clay</td> <td>0</td> <td>4</td> <td>59</td> <td>72</td> </tr> <tr> <td>Brown Sandstone</td> <td>4</td> <td>7</td> <td>72</td> <td>73</td> </tr> <tr> <td>Brown Rusty limestone</td> <td>7</td> <td>9</td> <td>73</td> <td>77</td> </tr> <tr> <td>Gray Shale</td> <td>9</td> <td>11</td> <td>77</td> <td>89</td> </tr> <tr> <td>Yellow Shale</td> <td>11</td> <td>12</td> <td>89</td> <td>96</td> </tr> <tr> <td>lt Gray limestone</td> <td>12</td> <td>13</td> <td>96</td> <td>99</td> </tr> <tr> <td>Br Rusty Limestone</td> <td>13</td> <td>14</td> <td>99</td> <td>110</td> </tr> <tr> <td>Brown Limestone</td> <td>14</td> <td>23</td> <td>110</td> <td>129</td> </tr> <tr> <td>Gray Limestone</td> <td>23</td> <td>31</td> <td>129</td> <td>133</td> </tr> <tr> <td>Gray Shale</td> <td>31</td> <td>34</td> <td>133</td> <td>140</td> </tr> <tr> <td>Tan limestone</td> <td>34</td> <td>39</td> <td></td> <td></td> </tr> <tr> <td>Gray Shale</td> <td>39</td> <td>50</td> <td></td> <td></td> </tr> <tr> <td>Gray limestone</td> <td>50</td> <td>51</td> <td></td> <td></td> </tr> <tr> <td>Brown Sandy shale</td> <td>51</td> <td>52</td> <td></td> <td></td> </tr> <tr> <td>Gray Shale</td> <td>52</td> <td>59</td> <td></td> <td></td> </tr>
(Use a second sheet if needed)	
6. Bore hole dia. <u>8</u> in. Completion date <u>8-19-77</u> Well depth <u>140</u> ft.	7. <input checked="" type="checkbox"/> Cable tool <input checked="" type="checkbox"/> Rotary <input type="checkbox"/> Driven <input type="checkbox"/> Dug <input type="checkbox"/> Hollow rod <input type="checkbox"/> Jetted <input type="checkbox"/> Bored <input type="checkbox"/> Reverse rotary	
8. Use: <input checked="" type="checkbox"/> Domestic <input type="checkbox"/> Public supply <input type="checkbox"/> Industry <input type="checkbox"/> Irrigation <input type="checkbox"/> Air conditioning <input type="checkbox"/> Stock <input type="checkbox"/> Lawn <input type="checkbox"/> Oil field water <input type="checkbox"/> Other	
9. Casing: Material <u>PVC</u> Height <u>Above</u> or below Threaded <input type="checkbox"/> Welded <input type="checkbox"/> Surface <u>24</u> in. RMP <input type="checkbox"/> PVC <u>One</u> Weight <u>2.74</u> lbs./ft. Dia. <u>5</u> in. to <u>140</u> ft. depth Wall Thickness: inches or Dia. <u>5</u> in. to <u>140</u> ft. depth gage No. <u>1252</u>	
10. Screen: Manufacturer's name <u>Temp 30</u> Type <u>PVC</u> Dia. <u>5"</u> Slot/gauze <u>080</u> Length <u>25</u> Set between <u>45-55</u> ft. and <u>65-70</u> ft. <u>90-100</u> ft. and _____ ft. Gravel pack? <input checked="" type="checkbox"/> Yes Size range of material <u>1/4 x 1/4</u>	
11. Static water level: _____ mo./day/yr. <u>50</u> ft. below land surface Date <u>8-19-77</u>	
12. Pumping level below land surfaces: <u>Air Test</u> _____ ft. after _____ hrs. pumping _____ g.p.m. _____ ft. after _____ hrs. pumping _____ g.p.m. Estimated maximum yield <u>15 GPH</u> g.p.m.	
13. Water sample submitted: _____ mo./day/yr. Yes <input checked="" type="checkbox"/> No <input type="checkbox"/> Date _____	
14. Well head completion: <u>Top Cap w/</u> <input type="checkbox"/> Pitless adapter <u>24</u> Inches above grade	
15. Well grouted? <u>Yes</u> With: <input checked="" type="checkbox"/> Neat cement <input type="checkbox"/> Bentonite <input type="checkbox"/> Concrete Depth: From <u>5</u> ft. to <u>15</u> ft.	
16. Nearest source of possible contamination: _____ ft. _____ Direction <u>NW</u> Type <u>Pond</u> Well disinfected upon completion? <input checked="" type="checkbox"/> Yes <input type="checkbox"/> No	
17. Pump: <input checked="" type="checkbox"/> Not installed Manufacturer's name _____ HP _____ Volts _____ Length of drop pipe _____ ft. capacity _____ g.p.m. Type: <input type="checkbox"/> Submersible <input type="checkbox"/> Turbine <input type="checkbox"/> Jet <input type="checkbox"/> Reciprocating <input type="checkbox"/> Centrifugal <input type="checkbox"/> Other	
18. Elevation: <u>870</u> <u>km</u> Topography: <input type="checkbox"/> Hill <input checked="" type="checkbox"/> Slope <input type="checkbox"/> Upland <input type="checkbox"/> Valley	19. Remarks: <u>owner will construct cement slab around well,</u>	
20. Water well contractor's certification: This well was drilled under my jurisdiction and this report is true to the best of my knowledge and belief. <u>Stroeder Dalg Co Inc</u> <u>182</u> Business name License No. Address <u>Holtan, KS</u> Signed <u>Dale Ashm</u> Date <u>8-22-77</u> Authorized representative	

T 12 S R 21 E/W

Forward the white, blue and pink copies to the Department of Health and Environment

Form WWC-5