

1 LOCATION OF WATER WELL: Fraction NW 1/4 NW 1/4 SW 1/4 Section Number 11 Township Number T 12 S Range Number R 21 EW
 County: LEAVENWORTH

Distance and direction from nearest town or city street address of well if located within city?


1 MILE WEST 1 MILE NORTH OF LINWOOD

2 WATER WELL OWNER: MR. HOUSER
 RR#, St. Address, Box #: 13318 206th RT1 Box 161
 City, State, ZIP Code: LINWOOD, KS 66052

Board of Agriculture, Division of Water Resources

Application Number:

3 LOCATE WELL'S LOCATION WITH AN "X" IN SECTION BOX:

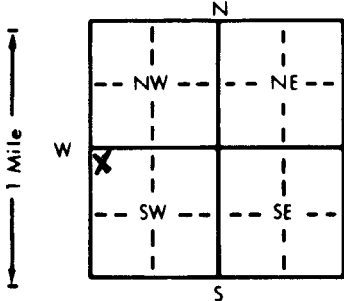

4 DEPTH OF COMPLETED WELL: 110 ft. ELEVATION:

Depth(s) Groundwater Encountered 1. 999 ft. 2. ft. 3. ft.

WELL'S STATIC WATER LEVEL 999 ft. below land surface measured on mo/day/yr

Pump test data: Well water was ft. after hours pumping gpm

Est. Yield 1/10 gpm Well water was ft. after hours pumping gpm

Bore Hole Diameter 6 3/4 in. to 23 ft. and 6 3/4 in. to 110 ft.

WELL WATER TO BE USED AS: 5 Public water supply 8 Air conditioning 11 Injection well

1 Domestic 3 Feedlot 6 Oil field water supply 9 Dewatering 12 Other (Specify below)

2 Irrigation 4 Industrial 7 Lawn and garden only 10 Monitoring well

Was a chemical/bacteriological sample submitted to Department? Yes No; If yes, mo/day/yr sample was submitted

Water Well Disinfected? Yes No

5 TYPE OF BLANK CASING USED:

- 1 Steel 3 RMP (SR)
 2 PVC 4 ABS

5 Wrought iron

8 Concrete tile

CASING JOINTS: Glued Clamped

6 Asbestos-Cement

9 Other (specify below)

Welded

7 Fiberglass

NONE

Threaded

Blank casing diameter 9 1/4 in. to ft., Dia. in. to ft., Dia. in. to ft.

Casing height above land surface 9 1/4 in., weight lbs./ft. Wall thickness or gauge No.

TYPE OF SCREEN OR PERFORATION MATERIAL:

- 1 Steel 3 Stainless steel
 2 Brass 4 Galvanized steel

5 Fiberglass

7 PVC

10 Asbestos-cement

8 RMP (SR)

11 Other (specify)

9 ABS

12 None used (open hole)

SCREEN OR PERFORATION OPENINGS ARE:

- 1 Continuous slot 3 Mill slot
 2 Louvered shutter 4 Key punched

5 Gauzed wrapped

8 Saw cut

11 None (open hole)

6 Wire wrapped

9 Drilled holes

7 Torch cut

10 Other (specify)

SCREEN-PERFORATED INTERVALS: From ft. to ft., From ft. to ft., From ft. to ft.

GRAVEL PACK INTERVALS: From ft. to ft., From ft. to ft., From ft. to ft.

6 GROUT MATERIAL: 1 Neat cement

2 Cement grout

3 Bentonite

4 Other

Grout Intervals: From ft. to ft., From ft. to ft., From ft. to ft.

What is the nearest source of possible contamination:

- 1 Septic tank 4 Lateral lines
 2 Sewer lines 5 Cess pool
 3 Watertight sewer lines 6 Seepage pit

7 Pit privy

10 Livestock pens

14 Abandoned water well

8 Sewage lagoon

11 Fuel storage

15 Oil well/Gas well

9 Feedyard

12 Fertilizer storage

16 Other (specify below)

13 Insecticide storage

IN PASTURE

Direction from well? NONE AT TIME OF DRILLING

How many feet?

FROM	TO	LITHOLOGIC LOG	FROM	TO	PLUGGING INTERVALS
0	4	SOIL	0	23	NEAT CEMENT
4	10	CLAY			
10	27	CLAY & SHALE	23	107	GRAVEL
27	31	SHALE			
31	41	GRAY SAND	107	110	NEAT CEMENT
41	49	SAND & SHALE			
49	53	SAND			
53	61	SHALE			
61	73	GRAY SAND			
73	103	LIME			
103	109	SHALE			
109	110	LIME			

7 CONTRACTOR'S OR LANDOWNER'S CERTIFICATION: This water well was (1) constructed, (2) reconstructed, or (3) plugged under my jurisdiction and was completed on (mo/day/year) 12/2/91 and this record is true to the best of my knowledge and belief. Kansas

Water Well Contractor's License No. This Water Well Record was completed on (mo/day/yr) 12/9/91

under the business name of POKHAN PUMP & WELL DRILLING INC. by (signature) Tom E. Pothman Jr.

INSTRUCTIONS: Use typewriter or ball point pen. PLEASE PRESS FIRMLY and PRINT clearly. Please fill in blanks, underline or circle the correct answers. Send top three copies to Kansas Department of Health and Environment, Bureau of Water, Topeka, Kansas 66620-0001. Telephone: 913-296-5545. Send one to WATER WELL OWNER and retain one for your records.