12

USE TYPEWRITER OR BALL POINT PEN-PRESS FIRMLY, PRINT CLEARLY.

WATER WELL RECORD
KSA 82a-1201-1215

Kansas Department of Health and Environment-Division of Environment
(Water well Contractors)
Topeka, Kansas 66620

1. Location of well:	County: Leavenworth	Fraction: SE 1/4 SE 1/4 NE 1/4	Section number: 13	Township number: T 12 S	Range number: R 21 E/W

2. Distance and direction from nearest town or city: 1 MI NE LINWOOD
Street address of well location if in city:

3. Owner of well: Dean Shores
R.R. or street: Box 173
City, state, zip code: Linwood Kans. 66056

4. Locate with "X" in section below:

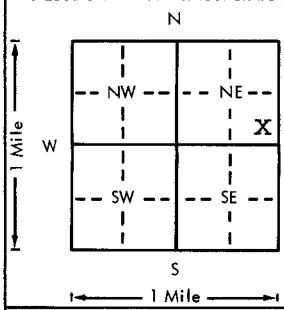

Sketch map:

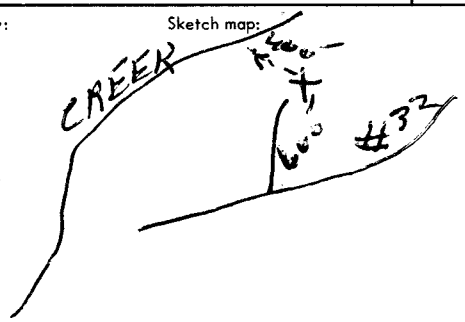

6. Bore hole dia. 8¾ in. Completion date 4-77
Well depth 204 ft.

7. X Cable tool __ Rotary __ Driven __ Dug
__ Hollow rod __ Jetted __ Bored __ Reverse rotary

8. Use: X Domestic __ Public supply __ Industry
__ Irrigation __ Air conditioning __ Stock
__ Lawn __ Oil field water __ Other

9. *Casing: Material steel with plastic liner Height: Above or below
Threaded __ X Welded __ Surface 12 in.
RMP X PVC __ Weight 1 lbs./ft.
Dia. 6 5/8 in. to 56 ft. depth Wall Thickness: inches or
Dia. 4½ in. to 204' ft. depth gage No. ¼"

10. Screen: Manufacturer's name J & L
Type plastic Dia. 4½"
Slot/ and perforated 151' Length
Set between 53' ft. and 204' ft.
ft. and ft.
Gravel pack? yes Size range of material ¼x1/8

11. Static water level: mo./day/yr.
40 ft. below land surface Date 4-77

12. Pumping level below land surfaces:
ft. after hrs. pumping g.p.m.
ft. after hrs. pumping g.p.m.
Estimated maximum yield 1/3 g.p.m.

13. Water sample submitted: mo./day/yr.
__ Yes X No Date

14. Well head completion:
__ Pitless adapter 12 Inches above grade

15. Well grouted? yes
With: X Neat cement __ Bentonite __ Concrete
Depth: From 5 ft. to 30 ft.

16. Nearest source of possible contamination:
ft. 400 Direction NW Type CREEK
Well disinfected upon completion? X Yes __ No

17. Pump: X Not installed
Manufacturer's name
Model number HP Volts
Length of drop pipe ft. capacity g.p.m.
Type:
__ Submersible __ Turbine
__ Jet __ Reciprocating
__ Centrifugal __ Other

5. Type and color of material	From	To
Silty sand with gravel	0	35
Lime lt. grey	35	50
Shale dark	50	53
Lime lt. grey	53	62
Shale lt grey	62	66
lime lt grey	66	73
Shale dk grey	73	76
Lime lt grey	76	99
Redbed	99	103
Shale greenish to dk grey gummy	103	115
Lime ~~med~~ ~~gray~~ light	115	161
Shale dark	161	165
Lime med grey	165	204
*56' 6 5/8 slotted with torch, 53' to 56'		
151' plastic liner 4½", perforated 3/32"		
from 53' to 204'.		

(Use a second sheet if needed)

18. Elevation: 820
Topography:
X Hill
__ Slope
__ Upland
__ Valley

19. Remarks: Customer is aware of State regulation and agrees to install a 4' square re-enforced concrete platform around top of well.

Dean Shores

20. Water well contractor's certification:
This well was drilled under my jurisdiction and this report is true to the best of my knowledge and belief.
F. E. Young Drilling Co 240
Business name License No.
Address 6355 Robinhood Ln. Merriam, Ks.
Signed F Young Authorized representative Date 6-11

Forward the white, blue and pink copies to the Department of Health and Environment

Form WWC-5

T 12 R 21 W Sec 13 1/4 SE 1/4 SE 1/4 NE

BR elev = 785 ▽ = ~~78~~ 780

M1-1023