

USE TYPEWRITER OR BALL
POINT PEN-PRESS FIRMLY,
PRINT CLEARLY.

no dot pen

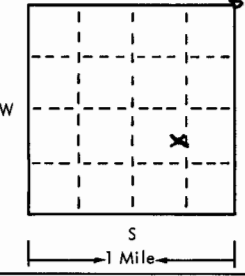
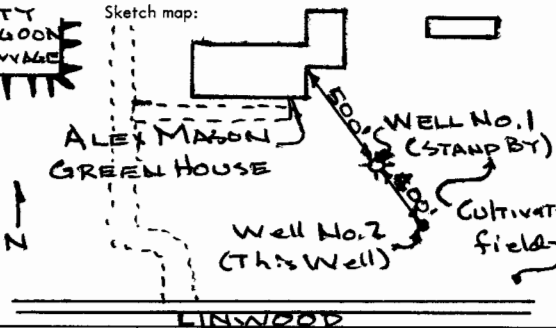
WATER WELL RECORD
KSA 82a-1201-1215

DATA ✓

T R EW sec 1/4 1/4 1/4 No.

Kansas State Dept. Of Health
(Water Well Contractors)
Forbes-Bldg. 740
Topeka, Kansas 66620

E/2 NWSE SUNE NE

1 Location of well:	County LEAVENWORTH	Township name	Fraction NE 1/4, SE 1/4 NW 1/4, SE 1/4	Section number 14	Town number 125	Range number 21E
Distance and direction from nearest town or city: 1/4 MILE N. OF LINWOOD				3 Owner of well: ALEX-MASSON, INC.		
Street address of well location if in city:				Address: LINWOOD, KANSAS		
Locate with "X" in section below: 		Sketch map: 		4 Well depth: 57 ft. Date of completion 2-20-75 Well diameter 20 in.		
2 Type and color of material		From To		5 <input type="checkbox"/> Cable tool <input checked="" type="checkbox"/> Rotary <input type="checkbox"/> Driven <input type="checkbox"/> Dug <input type="checkbox"/> Hollow rod <input type="checkbox"/> Jetted <input type="checkbox"/> Bored <input type="checkbox"/> Reverse rotary		
				6 Use: <input type="checkbox"/> Domestic <input type="checkbox"/> Public supply <input type="checkbox"/> Industry <input checked="" type="checkbox"/> Irrigation <input type="checkbox"/> Air conditioning <input type="checkbox"/> Commercial <input type="checkbox"/> Test well <input type="checkbox"/>		
				7 Casing: Material STEEL Height: above /below Threaded <input type="checkbox"/> Welded <input checked="" type="checkbox"/> Surface 24 in. Diam. Weight 40.5 lbs./ft. 10 in. to 50 ft. depth Drive shoe? <input type="checkbox"/> Yes <input checked="" type="checkbox"/> No — in. to — ft. depth		
				8 Screen: Manufacturer HOUSTON Type WIRE WOUND Dia. 10" Slot/gauze 0.040" Length 10'0" Set between 40 ft. and 50 ft. Fittings: Gravel pack <input checked="" type="checkbox"/> Yes <input type="checkbox"/> No Size range of material 2"		
				9 Static water level: 27 ft. below land surface Date 2-20-75		
TOPSOIL		0 2		10 Pumping level below land surfaces: 31.7 ft. after 1 hrs. pumping 50 g.p.m. 43.0 ft. after 6.5 hrs. pumping 100 g.p.m. Estimated maximum yield 50 g.p.m.		
BROWN SILTY CLAY		2 35		11 Water sample submitted: <input type="checkbox"/> Yes <input checked="" type="checkbox"/> No Date		
GRAY MEDIUM TO COARSE SAND		35 49		12 Well head completion: <input type="checkbox"/> Pitless adapter <input checked="" type="checkbox"/> Inches above grade		
W/TR. FINE SAND, GRAVEL				13 Well grouted? <input checked="" type="checkbox"/> Yes <input type="checkbox"/> No <input type="checkbox"/> Neat cement <input checked="" type="checkbox"/> Bentonite <input type="checkbox"/> Depth: From 0 ft. to 31 ft.		
GRAY LIMESTONE		49 50		14 Nearest source of possible contamination: CITY ft. 1500 Direction WNW Type Lagoon Well disinfected upon completion? <input checked="" type="checkbox"/> Yes <input type="checkbox"/> No		
				15 Pump: <input type="checkbox"/> Not installed Manufacturer's name FLOWAY Model number BLKL HP 3 Volts 230 Length of drop pipe 45 ft. capacity 50 g.p.m. Type: <input type="checkbox"/> Submersible <input checked="" type="checkbox"/> Turbine <input type="checkbox"/> Jet <input type="checkbox"/> Reciprocating <input type="checkbox"/> Centrifugal <input type="checkbox"/> Other		
				16 Remarks: elevation APPROXIMATELY 805' Topography: <input type="checkbox"/> Hill 800' <input type="checkbox"/> Slope 801' 2m <input type="checkbox"/> Upland <input checked="" type="checkbox"/> Valley		
				17 Water well contractor's certification: This well was drilled under my jurisdiction and this report is true to the best of my knowledge and belief. LATNE-WESTERN 149 Business name License No. Address KANSAS CITY, MO. Signed Dan B. [Signature] Date 2/27/76 Authorized representative		

Forward the white, blue and pink copies to the Kansas State Dept. Of Health.

Form WWC-5

BR elw = 756 $\nabla = 788$