

1 LOCATION OF WATER WELL: Fraction SW 1/4 SE 1/4 SE 1/4 Section Number 15 Township Number T 12 S Range Number R 21 E  
 County: LEAVENWORTH

Distance and direction from nearest town or city street address of well if located within city?

1 1/2 MILES WEST OF LINWOOD, KS

2 WATER WELL OWNER: LENARD BARTLETT

RR#, St. Address, Box #: RT1, BOX 34


Board of Agriculture, Division of Water Resources

City, State, ZIP Code: LINWOOD, KS

Application Number:

3 LOCATE WELL'S LOCATION WITH AN "X" IN SECTION BOX:

4 DEPTH OF COMPLETED WELL: 100 ft. ELEVATION: 860'

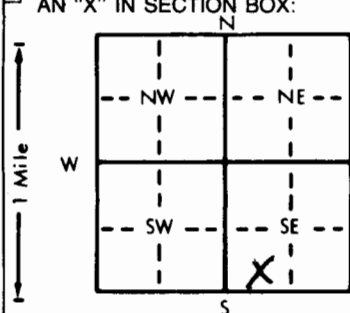

Depth(s) Groundwater Encountered 1. 33 ft. 2. 31 ft. 3. 10/2/89 ft.

WELL'S STATIC WATER LEVEL 31 ft. below land surface measured on mo/day/yr 10/2/89

Pump test data: Well water was 3/4 ft. after 8 1/2 hours pumping 100 gpm


Bore Hole Diameter 8 1/2 in. to 100 ft., and 100 in. to 100 ft.

WELL WATER TO BE USED AS: 5 Public water supply 8 Air conditioning 11 Injection well

1 Domestic 3 Feedlot 6 Oil field water supply 9 Dewatering 12 Other (Specify below)

2 Irrigation 4 Industrial 7 Lawn and garden only 10 Monitoring well

Was a chemical/bacteriological sample submitted to Department? Yes No X; If yes, mo/day/yr sample was submitted

Water Well Disinfected? Yes No

5 TYPE OF BLANK CASING USED:

1 Steel 3 RMP (SR)

2 PVC 4 ABS

5 Wrought iron

6 Asbestos-Cement

7 Fiberglass

8 Concrete tile

9 Other (specify below)

CASING JOINTS: Glued X Clamped

Welded

Threaded

Blank casing diameter 5" in. to 30 ft., Dia. 1.5 in. to 1.5 ft., Dia. 1.5 in. to 1.5 ft.

Casing height above land surface 24 in., weight 1.5 lbs./ft. Wall thickness or gauge No. SDR-26

TYPE OF SCREEN OR PERFORATION MATERIAL:

1 Steel 3 Stainless steel

2 Brass 4 Galvanized steel

5 Fiberglass

6 Concrete tile

7 PVC

8 RMP (SR)

9 ABS

10 Asbestos-cement

11 Other (specify)

12 None used (open hole)

SCREEN OR PERFORATION OPENINGS ARE:

1 Continuous slot 3 Mill slot

2 Louvered shutter 4 Key punched

5 Gauzed wrapped

6 Wire wrapped

7 Torch cut

8 Saw cut

9 Drilled holes

10 Other (specify)

11 None (open hole)

SCREEN-PERFORATED INTERVALS: From 31 ft. to 100 ft., From 31 ft. to 100 ft., From 31 ft. to 100 ft.


GRAVEL PACK INTERVALS: From 100 ft. to 24 ft., From 100 ft. to 24 ft., From 100 ft. to 24 ft.


6 GROUT MATERIAL:

1 Neat cement

2 Cement grout

3 Bentonite

4 Other

Grout Intervals: From 24 ft. to 3 ft., From 24 ft. to 3 ft., From 24 ft. to 3 ft.

What is the nearest source of possible contamination:

1 Septic tank 4 Lateral lines

2 Sewer lines 5 Cess pool

3 Watertight sewer lines 6 Seepage pit

7 Pit privy

8 Sewage lagoon

9 Feedyard

10 Livestock pens

11 Fuel storage

12 Fertilizer storage

13 Insecticide storage

14 Abandoned water well

15 Oil well/Gas well

16 Other (specify below)

POND

Direction from well?

How many feet? 275

FROM	TO	LITHOLOGIC LOG	FROM	TO	PLUGGING INTERVALS
0	1	SURFACE			
1	3	CLAY			
3	13	SANDSTONE (YELLOW)			
13	14	LIMESTONE			
14	33	SANDSTONE			
33	91	SHALE			
91	96	LIME			
96	100	SHALE			

7 CONTRACTOR'S OR LANDOWNER'S CERTIFICATION: This water well was (1) constructed, (2) reconstructed, or (3) plugged under my jurisdiction and was completed on (mo/day/year) 10/4/89 and this record is true to the best of my knowledge and belief. Kansas

Water Well Contractor's License No. 240 This Water Well Record was completed on (mo/day/yr) 11/14/89

under the business name of FE YOUNG DRILLING CO by (signature) Ed Young