

158?

USE TYPEWRITER OR BALL
POINT PEN-PRESS FIRMLY,
PRINT CLEARLY.

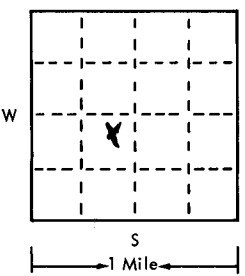
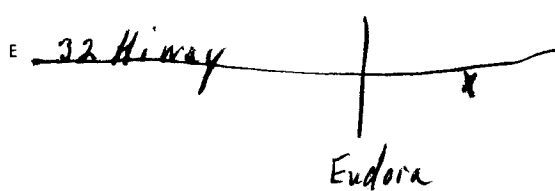
#?
dot?
nm
probably
158

CC A
WATER WELL RECORD
KSA 82a-1201-1215

NE SWSW

T R EW sec 1/4 1/4 1/4 No.

Kansas State Dept. Of Health
(Water Well Contractors)
Forbes-Bldg. 740
Topeka, Kansas 66620

1 Location of well:		County <u>Leavenworth</u>	Township name	Fraction <u>NE 1/4 SW 1/4</u>	Section number <u>16</u>	Town number <u>12</u>	Range number <u>21</u>		
Distance and direction from nearest town or city: <u>1/2 mi west of Linwood</u>				3 Owner of well: <u>Joe Robertson now owned by Harold Leach</u>					
Street address of well location if in city:				Address: <u>Linwood Kans.</u>					
Locate with "X" in section below:		Sketch map:		4 Well depth: <u>102</u> ft. Date of completion <u>7/24/75</u> Well diameter <u>6</u> in.					
				5 <input type="checkbox"/> Cable tool <input checked="" type="checkbox"/> Rotary <input type="checkbox"/> Driven <input type="checkbox"/> Dug <input type="checkbox"/> Hollow rod <input type="checkbox"/> Jetted <input type="checkbox"/> Bored <input type="checkbox"/> Reverse rotary					
2		Type and color of material		From		To		6 Use: <input checked="" type="checkbox"/> Domestic <input type="checkbox"/> Public supply <input type="checkbox"/> Industry <input type="checkbox"/> Irrigation <input type="checkbox"/> Air conditioning <input type="checkbox"/> Commercial <input type="checkbox"/> Test well <input type="checkbox"/>	
								7 Casing: Material <u>Steel</u> Height: <u>above</u> below Threaded <input type="checkbox"/> Welded <input type="checkbox"/> Surface <u>12</u> ft. Diam. <u>5</u> in. to <u>102</u> ft. depth Drive shoe? <input type="checkbox"/> Yes <input type="checkbox"/> No <u>5</u> in. to <u>102</u> ft. depth	
								8 Screen: Manufacturer <u>Field-Streene</u> Type <u>5"</u> Dia. <u>5"</u> Slot/gauze <u>3/16</u> Length <u>35</u> Set between <u>25</u> ft. and <u>102</u> ft. Fittings: Gravel pack <input checked="" type="checkbox"/> Yes <input type="checkbox"/> No Size range of material <u>1/4"</u>	
								9 Static water level: <u>35</u> ft. below land surface Date <u>7-24-75</u>	
								10 Pumping level below land surfaces: <u>102</u> ft. after <u>2</u> hrs. pumping <u>5</u> g.p.m. ____ ft. after ____ hrs. pumping ____ g.p.m. Estimated maximum yield <u>12-15</u> g.p.m./hour.	
								11 Water sample submitted: <input type="checkbox"/> Yes <input checked="" type="checkbox"/> No Date ____	
								12 Well head completion: <input type="checkbox"/> Pitless adapter <u>12</u> inches above grade	
								13 Well grouted? <input checked="" type="checkbox"/> Yes <input type="checkbox"/> No <input checked="" type="checkbox"/> Neat cement <input type="checkbox"/> Bentonite <input type="checkbox"/> Depth: From <u>0</u> ft. to <u>18</u> ft.	
								14 Nearest source of possible contamination: ft. <u>150</u> Direction <u>East</u> Type <u>Septic tank</u> Well disinfected upon completion? <input checked="" type="checkbox"/> Yes <input type="checkbox"/> No	
								15 Pump: <input checked="" type="checkbox"/> Not installed Manufacturer's name _____ Model number _____ HP _____ Volts _____ Length of drop pipe _____ ft. capacity _____ g.p.m. Type: <input type="checkbox"/> Submersible <input type="checkbox"/> Turbine <input type="checkbox"/> Jet <input type="checkbox"/> Reciprocating <input type="checkbox"/> Centrifugal <input type="checkbox"/> Other	
16 Remarks: elevation <u>930</u> Owner to install slab Topography: <input checked="" type="checkbox"/> Hill <input type="checkbox"/> Slope <input checked="" type="checkbox"/> Upland <input type="checkbox"/> Valley				17 Water well contractor's certification: This well was drilled under my jurisdiction and this report is true to the best of my knowledge and belief. <u>Robison Drilling 316A</u> Business name <u>Perry P.S.</u> License No. _____ Address _____ Signed <u>Jack Robison</u> Date _____ Authorized representative					

Forward the white, blue and pink copies to the Kansas State Dept. Of Health.

Form WWC-5

BR elev = 920 $\nabla = 895$