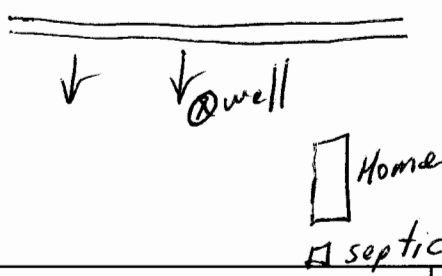


USE TYPEWRITER OR BALL
POINT PEN-PRESS FIRMLY,
PRINT CLEARLY.

WATER WELL RECORD
KSA 82a-1201-1215

Kansas Department of Health and
Environment-Division of Environment
(Water well Contractors)
Topeka, Kansas 66620

134

1. Location of well:	County <u>Levernworth.</u>	Fraction <u>1/4 SW 1/4 SW 1/4</u>	Section number <u>29</u>	Township number <u>T 12 S</u>	Range number <u>R 21 E E/W</u>																															
2. Distance and direction from nearest town or city: Street address of well location if in city: <u>Block 3 - Fall Leaf</u>			3. Owner of well: <u>Michael Larimer</u> R.R. or street: City, state, zip code: <u>Fall Leaf</u>																																	
4. Locate with "X" in section below: N W E S 1 Mile		Sketch map: 		6. Bore hole dia. <u>6 1/2</u> in. Completion date <u>2-19-77</u> Well depth <u>46</u> ft.																																
5. Type and color of material		From To		7. <input checked="" type="checkbox"/> Cable tool <input type="checkbox"/> Rotary <input type="checkbox"/> Driven <input type="checkbox"/> Dug <input type="checkbox"/> Hollow rod <input type="checkbox"/> Jetted <input type="checkbox"/> Bored <input type="checkbox"/> Reverse rotary																																
				8. Use: <input checked="" type="checkbox"/> Domestic <input type="checkbox"/> Public supply <input type="checkbox"/> Industry <input type="checkbox"/> Irrigation <input type="checkbox"/> Air conditioning <input type="checkbox"/> Stock <input type="checkbox"/> Lawn <input type="checkbox"/> Oil field water <input type="checkbox"/> Other																																
				9. Casing: Material <u>Steel</u> Height: Above or below Threaded <input type="checkbox"/> Welded <input checked="" type="checkbox"/> Surface <u>12</u> in. RMP <input checked="" type="checkbox"/> PVC <input type="checkbox"/> Weight <u>188</u> lbs./ft.																																
				Dia. <u>6 1/2</u> in. to <u>31</u> ft. depth Wall Thickness: inches or Dia. <u>5</u> in. to <u>26 1/2</u> ft. depth gage No. <u>200</u>																																
<table border="1" style="width:100%; border-collapse: collapse;"> <tr><td><u>Top Soil</u></td><td><u>0</u></td><td><u>6</u></td></tr> <tr><td><u>Clay black</u></td><td><u>6</u></td><td><u>18</u></td></tr> <tr><td><u>Sand Fine dirty</u></td><td><u>18</u></td><td><u>21</u></td></tr> <tr><td><u>Sand coarse dirty</u></td><td><u>21</u></td><td><u>22</u></td></tr> <tr><td><u>Sandstone grey</u></td><td><u>22</u></td><td><u>25</u></td></tr> <tr><td><u>Shale sandy</u></td><td><u>25</u></td><td><u>31</u></td></tr> <tr><td><u>Lime grey</u></td><td><u>31</u></td><td><u>35</u></td></tr> <tr><td><u>shale grey</u></td><td><u>35</u></td><td><u>36</u></td></tr> <tr><td><u>Lime Light grey</u></td><td><u>36</u></td><td><u>38</u></td></tr> <tr><td><u>Shale grey</u></td><td><u>38</u></td><td><u>41</u></td></tr> <tr><td><u>Lime Light grey</u></td><td><u>41</u></td><td><u>46</u></td></tr><u>41</u>	<u>Lime Light grey</u>	<u>41</u>	<u>46</u>	10. Screen: Manufacturer's name <u>Sun Flower</u> Type <u>RMP</u> Dia. <u>5</u> Slot/gauze <u>3/16</u> Length <u>20</u> Set between <u>26</u> ft. and <u>46</u> ft. Gravel pack? <u>no</u> Size range of material	
11. Static water level: <u>5</u> ft. below land surface Date <u>2/19/77</u>																																				
12. Pumping level below land surfaces: ____ ft. after ____ hrs. pumping ____ g.p.m. ____ ft. after ____ hrs. pumping ____ g.p.m. Estimated maximum yield <u>8-10</u> g.p.m.																																				
13. Water sample submitted: ____ Yes <input checked="" type="checkbox"/> No Date ____																																				
14. Well head completion: ____ Pitless adapter <u>12</u> Inches above grade																																				
15. Well grouted? <input checked="" type="checkbox"/> With: <input checked="" type="checkbox"/> Neat cement <input type="checkbox"/> Bentonite <input type="checkbox"/> Concrete Depth: From <u>0</u> ft. to <u>16</u> ft.																																				
16. Nearest source of possible contamination: ft. <u>100+</u> Direction <u>South</u> Type <u>Septic</u> Well disinfected upon completion? <input checked="" type="checkbox"/> Yes <input type="checkbox"/> No																																				
17. Pump: <input checked="" type="checkbox"/> Not installed Manufacturer's name _____ Model number _____ HP _____ Volts _____ Length of drop pipe _____ ft. capacity _____ g.p.m. Type: ____ Submersible _____ Turbine ____ Jet _____ Reciprocating ____ Centrifugal _____ Other																																				
(Use a second sheet if needed)																																				
18. Elevation: <u>815</u> km Topography: <input type="checkbox"/> Hill <input type="checkbox"/> Slope <input type="checkbox"/> Upland <input checked="" type="checkbox"/> Valley	19. Remarks: <u>owner to install slab</u>		20. Water well contractor's certification: This well was drilled under my jurisdiction and this report is true to the best of my knowledge and belief. <u>Robison Drilling 316</u> Business name License No. Address <u>Perry ks</u> Signed <u>Jack Robison</u> Date <u>3/19/77</u> Authorized representative																																	

T 12 S R 21 E W 29 S 1/4 1/4 1/4