

1 LOCATION OF WATER WELL: Fraction NE 1/4 NE 1/4 NE 1/4 Section Number 29 Township Number T 12 S Range Number R 21 E  
 County: LEAVENWORTH

Distance and direction from nearest town or city street address of well if located within city?

3 MILES NORTH OF EUDORA

2 WATER WELL OWNER: ALICE KUHLMAN


RR#, St. Address, Box #: RT 1 BOX 68

City, State, ZIP Code: LINWOOD, KS

Board of Agriculture, Division of Water Resources

Application Number:

3 LOCATE WELL'S LOCATION WITH AN "X" IN SECTION BOX:

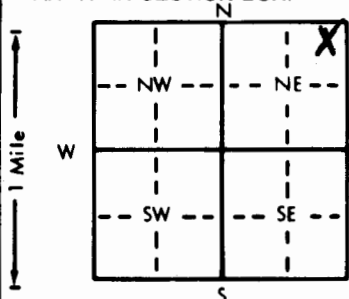

4 DEPTH OF COMPLETED WELL: 39' ft. ELEVATION:

Depth(s) Groundwater Encountered 1. 19 ft. 2. 12-6-91 ft. 3. 12-6-91 ft.

WELL'S STATIC WATER LEVEL 24 ft. below land surface measured on mo/day/yr

Pump test data: Well water was 1 ft. after 1 hours pumping 1 gpm

Est. Yield 1 gpm: Well water was 1 ft. after 1 hours pumping 1 gpm

Bore Hole Diameter 8 in. to 39 ft., and 39 in. to 39 ft.

WELL WATER TO BE USED AS: 5 Public water supply 8 Air conditioning 11 Injection well

1 Domestic 3 Feedlot 6 Oil field water supply 9 Dewatering 12 Other (Specify below)

2 Irrigation 4 Industrial 7 Lawn and garden only 10 Monitoring well

Was a chemical/bacteriological sample submitted to Department? Yes ✓ No ✓; If yes, mo/day/yr sample was submitted

Water Well Disinfected? Yes ✓ No ✓

5 TYPE OF BLANK CASING USED:

5 Wrought iron

8 Concrete tile

CASING JOINTS: Glued ✓ Clamped ✓

1 Steel

3 RMP (SR)

6 Asbestos-Cement

9 Other (specify below)

Welded ✓

2 PVC

4 ABS

7 Fiberglass

Threaded ✓

Blank casing diameter 5 in. to 22 ft., Dia 5 in. to 39 ft., Dia 5 in. to 39 ft.

Casing height above land surface 22 in., weight 5 lbs./ft. Wall thickness or gauge No. SDR-26

TYPE OF SCREEN OR PERFORATION MATERIAL:

1 Steel

3 Stainless steel

5 Fiberglass

1 PVC

10 Asbestos-cement

2 Brass

4 Galvanized steel

6 Concrete tile

8 RMP (SR)

11 Other (specify)

SCREEN OR PERFORATION OPENINGS ARE:

5 Gauzed wrapped

8 Saw cut

11 None (open hole)

1 Continuous slot

3 Mill slot

6 Wire wrapped

9 Drilled holes

2 Louvered shutter

4 Key punched

7 Torch cut

10 Other (specify)

SCREEN-PERFORATED INTERVALS: From 22 ft. to 31 ft., From 31 ft. to 39 ft.

GRAVEL PACK INTERVALS: From 22 ft. to 39 ft., From 39 ft. to 39 ft.

6 GROUT MATERIAL: 1 Neat cement

2 Cement grout

3 Bentonite

4 Other

Grout intervals: From 2 ft. to 22 ft., From 22 ft. to 31 ft., From 31 ft. to 39 ft.

What is the nearest source of possible contamination:

10 Livestock pens

14 Abandoned water well

1 Septic tank

4 Lateral lines

7 Pit privy

11 Fuel storage

15 Oil well/Gas well

2 Sewer lines

5 Cess pool

8 Sewage lagoon

12 Fertilizer storage

16 Other (specify below)

3 Watertight sewer lines

6 Seepage pit

9 Feedyard

13 Insecticide storage

Direction from well?

NORTH WEST

How many feet?

100'

FROM	TO	LITHOLOGIC LOG	FROM	TO	PLUGGING INTERVALS
0	2	SOIL			
2	19	CLAY			
19	23	SAND			
23	31	LIME			
31	38	SHALE			
38	39	LIME			

7 CONTRACTOR'S OR LANDOWNER'S CERTIFICATION: This water well was (1) constructed, (2) reconstructed, or (3) plugged under my jurisdiction and was completed on (mo/day/year) 5-26-92 and this record is true to the best of my knowledge and belief. Kansas

Water Well Contractor's License No. 536 This Water Well Record was completed on (mo/day/yr) 5-26-92

under the business name of Patchen Pump & Well Drilling Inc. by signature Tom Patchen