


1 LOCATION OF WATER WELL:	Fraction	Section Number	Township Number	Range Number
County: <u>LEARN WORTH</u>	<u>SE 1/4 NW 1/4 SW 1/4</u>	<u>30</u>	T <u>12</u> S	R <u>21</u> EW

Distance and direction from nearest town or city street address of well if located within city?

5 MEAS - LAWRENCE 3 E ON 32 2 1/4 SOUTH

2 WATER WELL OWNER:	Board of Agriculture, Division of Water Resources
RR#, St. Address, Box #:	Application Number:
City, State, ZIP Code:	

3 LOCATE WELL'S LOCATION WITH AN "X" IN SECTION BOX:	4 DEPTH OF COMPLETED WELL:	ft. ELEVATION:
--	----------------------------	----------------

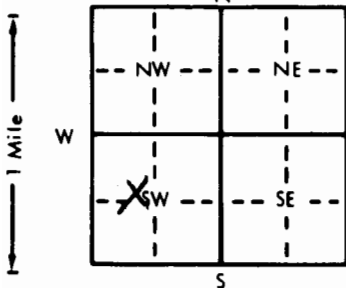

Depth(s) Groundwater Encountered 1. 69 ft. 2. 83 ft. 3. 83 ft.

WELL'S STATIC WATER LEVEL 69 ft. below land surface measured on mo/day/yr SEP 12 89




WELL WATER TO BE USED AS:

1 Domestic 3 Feedlot 6 Oil field water supply 9 Dewatering 12 Other (Specify below)

2 Irrigation 4 Industrial 7 Lawn and garden only 10 Monitoring well

Was a chemical/bacteriological sample submitted to Department? Yes No If yes, mo/day/yr sample was submitted

Water Well Disinfected? Yes No

5 TYPE OF BLANK CASING USED:	5 Wrought iron	8 Concrete tile	CASING JOINTS
------------------------------	----------------	-----------------	---------------

1 Steel 3 RMP (SR) 6 Asbestos-Cement 9 Other (specify below) Welded

2 PVC 4 ABS 7 Fiberglass Threaded

Blank casing diameter 5 in. to 76 ft. Dia 12 in. to SDA 26 lbs./ft. Wall thickness or gauge No.

Casing height above land surface 12 in. weight SDA 26 lbs./ft. Wall thickness or gauge No.

TYPE OF SCREEN OR PERFORATION MATERIAL:

1 Steel 3 Stainless steel 5 Fiberglass 8 RMP (SR) 11 Other (specify)

2 Brass 4 Galvanized steel 6 Concrete tile 9 ABS 12 None used (open hole)

SCREEN OR PERFORATION OPENINGS ARE:

1 Continuous slot 3 Mill slot 5 Gauzed wrapped 8 Saw cut 11 None (open hole)

2 Louvered shutter 4 Key punched 6 Wire wrapped 9 Drilled holes 10 Other (specify)

SCREEN-PERFORATED INTERVALS: From 24 ft. to 83 ft. From 24 ft. to 83 ft.




7 CONTRACTOR'S OR LANDOWNER'S CERTIFICATION: This water well was (1) constructed, (2) reconstructed, or (3) plugged under my jurisdiction and was completed on (mo/day/year) SEP 14 89 and this record is true to the best of my knowledge and belief. Kansas

Water Well Contractor's License No. 119 This Water Well Record was completed on (mo/day/yr) SEP 24 - 89

under the business name of TUNEMANN DMS DRILLING CO by (signature) [Signature]

INSTRUCTIONS: Use typewriter or ball point pen. PLEASE PRESS FIRMLY and PRINT clearly. Please fill in blanks, underline or circle the correct answers. Send top three copies to Kansas Department of Health and Environment, Bureau of Water Protection, Topeka, Kansas 66620-7320. Telephone: 913-296-5514. Send one to WATER WELL OWNER and retain one for your records.

160802068-13