WATER WELL RECORD Form WWC-5 KSA 82a-1212

1 LOCATION OF WATER WELL: County: Leavenworth | Fraction: NW ¼ SE ¼ SE ¼ | Section Number: 30 | Township Number: T 12 S | Range Number: R 21e E/W

Distance and direction from nearest town or city street address of well if located within city?
1200 ft. east Fall Leaf

2 WATER WELL OWNER: Louis Box
RR#, St. Address, Box # : 8001 Grandview
City, State, ZIP Code : Overland Park, KS
Board of Agriculture, Division of Water Resources
Application Number:

3 LOCATE WELL'S LOCATION WITH AN "X" IN SECTION BOX:

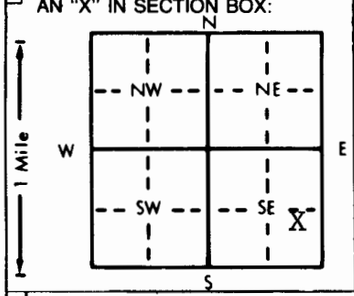

4 DEPTH OF COMPLETED WELL 80 ft. ELEVATION:
Depth(s) Groundwater Encountered 1. 55 ft. 2. ft. 3. ft.
WELL'S STATIC WATER LEVEL 37 ft. below land surface measured on mo/day/yr 10-23-91
Pump test data: Well water was ft. after hours pumping gpm
Est. Yield 13 gpm: Well water was ft. after hours pumping gpm
Bore Hole Diameter 18 in. to 25 ft., and 8.5 in. to 80 ft.
WELL WATER TO BE USED AS: #1 5 Public water supply 8 Air conditioning 11 Injection well
* Domestic 3 Feedlot 6 Oil field water supply 9 Dewatering 12 Other (Specify below)
2 Irrigation 4 Industrial 7 Lawn and garden only 10 Monitoring well
Was a chemical/bacteriological sample submitted to Department? Yes No X; If yes, mo/day/yr sample was submitted
Water Well Disinfected? Yes X No

5 TYPE OF BLANK CASING USED: #2 5 Wrought iron 8 Concrete tile CASING JOINTS: Glued X Clamped
1 Steel 3 RMP (SR) 6 Asbestos-Cement 9 Other (specify below) Welded
*2 PVC 4 ABS 7 Fiberglass Threaded
Blank casing diameter 5 in. to 80 ft., Dia in. to ft., Dia in. to ft.
Casing height above land surface 18 in., weight .284 lbs./ft. Wall thickness or gauge No. .265
TYPE OF SCREEN OR PERFORATION MATERIAL: #7 * 7 PVC 10 Asbestos-cement
1 Steel 3 Stainless steel 5 Fiberglass 8 RMP (SR) 11 Other (specify)
2 Brass 4 Galvanized steel 6 Concrete tile 9 ABS 12 None used (open hole)
SCREEN OR PERFORATION OPENINGS ARE: #3 5 Gauzed wrapped 8 Saw cut 11 None (open hole)
1 Continuous slot 3 Mill slot 6 Wire wrapped 9 Drilled holes
2 Louvered shutter 4 Key punched 7 Torch cut 10 Other (specify)
SCREEN-PERFORATED INTERVALS: From 70' ft. to 80' ft., From ft. to ft.
From ft. to ft., From ft. to ft.
GRAVEL PACK INTERVALS: From 20' ft. to 80' ft., From ft. to ft.
From ft. to ft., From ft. to ft.

6 GROUT MATERIAL: #1 2 3 1 Neat cement 2 Cement grout 3 Bentonite 4 Other
Grout Intervals: From 3 ft. to 20 ft., From ft. to ft., From ft. to ft.
What is the nearest source of possible contamination: #1
1 Septic tank 4 Lateral lines 7 Pit privy 10 Livestock pens 14 Abandoned water well
2 Sewer lines 5 Cess pool 8 Sewage lagoon 11 Fuel storage 15 Oil well/Gas well
3 Watertight sewer lines 6 Seepage pit 9 Feedyard 12 Fertilizer storage 16 Other (specify below)
13 Insecticide storage
Direction from well? 150' SE How many feet?

FROM	TO	LITHOLOGIC LOG	FROM	TO	PLUGGING INTERVALS
0	25	Sandy Soil			
25	51	Gray sand			
51	55	Sand silt			
55	55.6	?Black slate			
55.6	80	Shale			

7 CONTRACTOR'S OR LANDOWNER'S CERTIFICATION: This water well was (1) constructed, (2) reconstructed, or (3) plugged under my jurisdiction and was completed on (mo/day/year) #1 10-23-91 and this record is true to the best of my knowledge and belief. Kansas Water Well Contractor's License No. 174 This Water Well Record was completed on (mo/day/yr) 10-23-91
under the business name of Breuer Inc. by (signature) John S. Breuer
John S. Breuer

INSTRUCTIONS: Use typewriter or ball point pen. *PLEASE PRESS FIRMLY* and *PRINT* clearly. Please fill in blanks, underline or circle the correct answers. Send top three copies to Kansas Department of Health and Environment, Bureau of Water, Topeka, Kansas 66620-0001. Telephone: 913-296-5545. Send one to WATER WELL OWNER and retain one for your records.

OFFICE USE ONLY T R E/W SEC. ¼ ¼ ¼