

KANSAS WELL SCHEDULE

Card 1

Record by Kans Date: 4-25²³ Project: top KC State: Kan R County: Leav 52
Latitude: _____ Longitude: _____ Accuracy: _____ Owner's well no: _____
Location: SE SW SW no. sec. 3 T. 12 N., R. 21 E. Well number: 1221E 3CCD
Owner: Harold Turner name address
Owner: HAROLD TURNER 15 16 17 18 19 20 21 22 23 24 25 26 27 28 29 30 31 32 33 34 35 36 37 38 Altitude: _____ lsd _____ Accuracy _____
Driller: _____ name address Date drilled: _____
Topography, well site: (D) Draw, (F) flood plain, (L) lowland, (R) rolling, (S) slope, (T) terrace, (U) upland L Spring, or depth of well: 30.6 306 M 1 4-25-23 39.6
Diameter: 5 inches 51 52 Depth cased: _____ feet 53 54 55 Spring, or Csg. type: Drill B Finish: _____ Lift & power: _____
Pump setting: _____ feet 59 60 61 Use of well: Domestic, stock, irrigation, industrial, public supply, observation, none, test 7
Water level: 3.6 above lsd 36 M 1 4-25-23 073 Water level records avail. _____
Description MP: Top Casing 1.0 above lsd
Yield: _____ gpm 71 72 73 74 accuracy _____ 75 Pumping period: _____ hours or days 76 77 Specific capacity: _____ gpm/ft. dd 78 79
Pumpage and other data available: _____ 80

Card 2

Coefficient trans: _____ gpd/ft 15 16 17 Coefficient storage: _____ 18 19 20 Coefficient perm.: _____ gpd/ft²
Aquifer, system or series: _____ 21 _____ 22 _____ 23 _____ 24
Aquifer, units: _____ 25 26 27 _____ 28 29 30 _____ 31 32 33
_____ 34 35 36 _____ 37 38 39 _____ 40 41 42 _____ 43 44 45
Aquifer, thickness: _____ feet 46 47 48 Aquifer, length of well open to: _____ feet 49 50 51 Aquifer, depth to top of: _____ feet 52 53 54 Aquifer, origin: _____
Aquifer, lithology of: _____ 55 56
Bedrock, system: _____ 57 Bedrock, formation: _____ 58 59 60 Bedrock, depth to: _____ feet 61 62 63
Surficial material: _____ lithology _____ infiltration characteristics Log data avail: No log _____ 64
Quality of water data available: _____ 65 Temperature of water: _____ °F. 66 67 Date sampled: _____ 68 69 70
Coefficient of leakage: _____




THE FOLLOWING DATA ARE USED ON THE NATIONAL WELL SCHEDULE

Ownership category: (C) County, (F) Federal Gov't., (M) City, (N) Corp. or Co., (P) Private, (S) State Agency, (W) Water Dist. P
Method drilled: (A) Air, (B) bored, (C) cable, (D) dug, (V) driven, (H) hyd. rotary, (J) jetted, (R) rev. rotary, (T) trenching, (S) spring, D
Physiographic province: _____ 73 74 Section: _____
Drainage basin: _____ 75 76 Subbasin: _____ Depth to basement: _____ 77 78 79 source of data (basement) _____ 80

Quadrangle _____

Well no. 12-21E - 3 CCD

2022

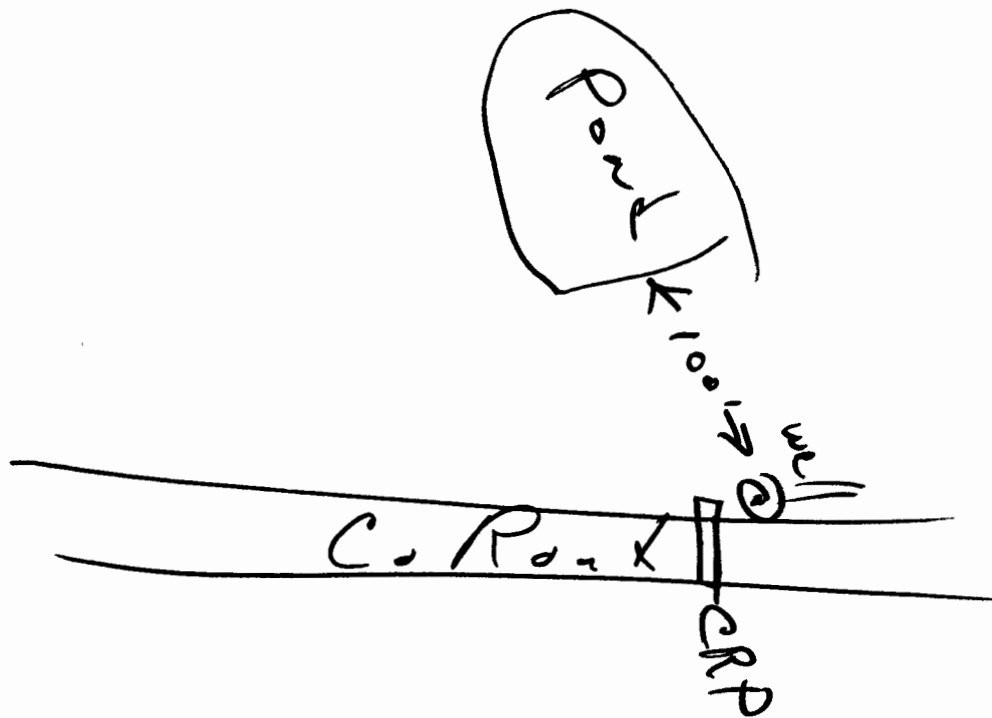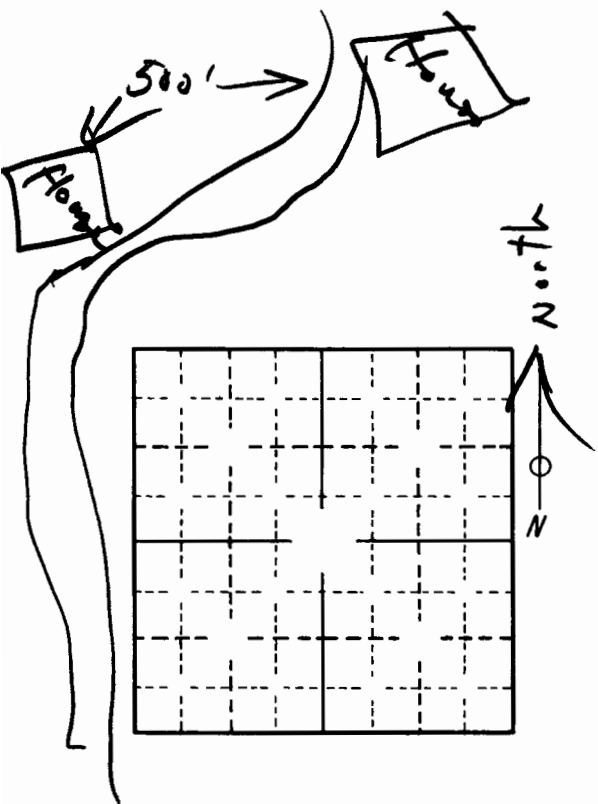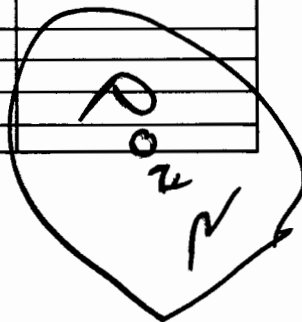

LS/100