

KANSAS WELL SCHEDULE

Card 1

Not in
12-21E-4C

Record by: Kherash with Date: 4-25-73 Project: Top-KC State: Kans K County: Leaw 52
 Latitude: _____ Longitude: _____ Accuracy: _____ Owner's well no.: _____
 Location: _____ SW no. sec. 4 T. 12 N., R. 28 E. Well number: 1221E 4C
 Owner: John Gilliland RT address: Litwood
 Owner: JOHN GILLILAND Altitude: _____ Accuracy: _____
 Driller: _____ name Hand Dug address _____ Date drilled: _____
 Topography, well site: (D) _____ (F) _____ (L) Hand (R) _____ (S) _____ (T) _____ (U) _____ L Spring; or depth of well: 28' _____ 28 R 3
 Draw, flood plain, lowland, rolling, slope, terrace, upland
 Diameter: 3.4' 48 inches of feet _____ Depth cased: _____ _____ _____ Spring, or Csg. type: _____ Finish: _____ Lift & power: _____
 Pump setting: _____ feet _____ Use of well: Domestic, stock, irrigation, industrial, public supply, observation, none, test _____ 9
 Water level: 20 above lsd _____ 20 R 3 _____ 073 date measured _____ Water level records avail. _____
 Description MP: Sealed For Diary use _____ above lsd _____
 Yield: _____ gpm _____ _____ Pumping period: _____ hours or days _____ Specific capacity: _____ gpm/ft. dd _____
 Pumpage and other data available: _____

Card 2



Coefficient trans: _____ gpd/ft _____ Coefficient storage: _____ _____ Coefficient perm.: _____ gpd/ft².
 Aquifer, system or series _____
 Aquifer, units _____
 Aquifer, thickness: _____ feet _____ Aquifer, length of well open to: _____ feet _____ Aquifer, depth to top of: _____ feet _____ Aquifer, origin: _____
 Aquifer, lithology of: _____
 Bedrock, system: _____ Bedrock, formation: _____ Bedrock, depth to: _____ feet _____
 Surficial material: _____ lithology _____ infiltration characteristics _____ Log data avail: No Log _____
 Quality of water data available: _____ Temperature of water: _____ °F. _____ Date sampled: _____
 Coefficient of leakage _____

THE FOLLOWING DATA ARE USED ON THE NATIONAL WELL SCHEDULE

Ownership category: (C) _____ (F) _____ (M) _____ (N) _____ (P) Private (S) _____ (W) _____ P
 County, Federal Gov't., City, Corp. or Co., State Agency, Water Dist.
 Method drilled: (A) _____ (B) _____ (C) _____ (D) Aug (V) _____ (H) _____ (J) _____ (R) _____ (T) _____ (S) _____ D
 Air, bored, cable, driven, hyd. rotary, jetted, rev. rotary, trenching, spring
 Physiographic province: _____ Section: _____
 Drainage basin: _____ Subbasin: _____ Depth to basement: _____ source of data (basement) _____

Quadrangle

Well no. 12-21E-4C

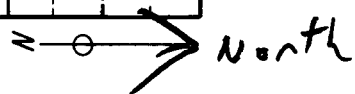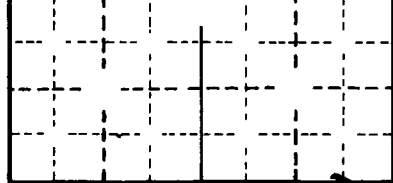

Entrance to Temperance Highway

Milk House

Barn

well
House

