

DRILLERS LOG OF WELL[illegible]

Well Owner Mr. John Green

Address Linwood, Kan.

Drilling Contractor Breuer Drilling Co.

Date Drilled July 1, 1972

Method of Drilling Cable tool
(Cable tool, rotary, reverse rotary, etc.)

Casing Schedule 12 1/2 in. Plastic 6 1/2 in.
(Amount, Size, Setting—New, Used—Steel, Galv.—Gage or Weight)

Screen Data (if any): _____
(Length, Diameter, Slot Size, Setting)

Measured depth to water on completed well (Static Level) is

12 _____ ft. below **Land Surface**
(Land Surface, Top of Casing, Etc.)

TESTED YIELD: _____ gallons per _____
(Min., Hour)

as determined by Bailing
(Bailing, Test Pumping, Etc.)

DRAWDOWN: _____ ft. after _____ hrs.

pumping at _____ gal. per minute.

REMARKS:

LOCATION OF WELL Topographic Sheet Tongantla
[Show location in Section Plat] Elev. 9.00 ±

NW 1/4 SW 1/4 Sec. 11
 T. 12 S., R. 21 E.
 County Rea
 BR-700-210

KANSAS WELL SCHEDULE

Card 1

5-1-73 12:33
B.H.H. = 150

Record by: Merwin Date: 4-25-73 Project: Top-KC State: Kans County: Lea 52

Latitude: _____ Longitude: _____ Accuracy: _____ Owner's well no: _____

Location: NW SW no. sec. 11 T. 12 N., R. 21 E. Well number: 1221E11CB

Owner: John Green address Linwood

Owner: JOHN GREEN Altitude: _____ Accuracy: _____

Driller: Breuer Date drilled: July 1-72

Topography, well site: (D) Draw, (F) flood plain, (L) lowland, (R) rolling, (S) slope, (T) terrace, (U) pland Spring; or depth of well: 120 120 3

Diameter: 6 06 Depth cased: 120 120 Spring, or Csg. type: Plastic Finish: _____ Lift & power: sub-elec Q

Pump setting: _____ Use of well: Domestic stock, irrigation, industrial, public supply, observation, none, test _____

Water level: 11.0 above 110 M 1 4-25-73 D73 Water level records avail. _____

Description MP: Top Casing 0.5 above yard

Yield: 4 4 R 3 Pumping period: _____ Specific capacity: _____

Pumpage and other data available: _____

Card 2

Coefficient trans: _____ Coefficient storage: _____ Coefficient perm.: _____

Aquifer, system or series: _____

Aquifer, units: _____

Aquifer, thickness: _____ Aquifer, length of well open to: _____ Aquifer, depth to top of: _____ Aquifer, origin: _____

Aquifer, lithology of: _____

Bedrock, system: _____ Bedrock, formation: _____ Bedrock, depth to: _____

Surficial material: _____ Log data avail: Driller's log

Quality of water data available: _____ Temperature of water: _____ Date sampled: _____

Coefficient of leakage: _____

THE FOLLOWING DATA ARE USED ON THE NATIONAL WELL SCHEDULE

Ownership category: (C) County, (F) Federal Gov't., (M) City, (N) Corp. or Co., (P) Private, (S) State Agency, (W) Water Dist. P

Method drilled: (A) Air, (B) bored, (C) cable, (D) dug, (V) driven, (H) hyd. rotary, (J) jetted, (R) rev. rotary, (T) trenching, (S) spring, C


Physiographic province: _____ Section: _____

Drainage basin: _____ Subbasin: _____ Depth to basement: _____ source of data (basement) _____

Quadrangle

Well no. 12-21E-11CB

another four feet east

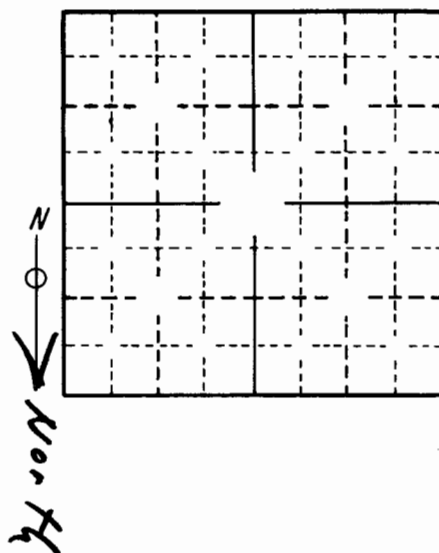

3 B. 5
H. 10. 12
L. 2. 7. 1

Dear Poet

751

2m

[illegible]