

KANSAS WELL SCHEDULE

Card 1

Record by Klerach Date: 4-27 Project: Top-Ke State: Kan County: Leav 52

Latitude: _____ deg min sec Longitude: _____ deg min sec Accuracy: _____ Owner's well no: _____

Location: _____ NE no. sec. 14 T. 12 N., R. 21 E. Well number: 1221E14A

Owner: Leland Baird name address

Owner: LELAND BAIRD Altitude: 851 865 Accuracy 3

Driller: _____ name address Date drilled: 71

Topography, well site: (D) Draw, (F) flood plain, (L) lowland, (R) rolling, (S) slope, (T) terrace, (U) upland, (V) Spring; or depth of well: Pond-Spring Fed R 3

Diameter: _____ inches or feet 51 52 Depth cased: _____ feet 53 54 55 Spring, or Csg. type: _____ 56 Finish: _____ 57 Lift & power: _____ 58

Pump setting: _____ feet 59 60 61 Use of well: Domestic stock, irrigation, industrial, public supply, observation, none, test _____ 62

Water level: _____ above lsd _____ below lsd _____ 63 64 65 accuracy 66 date measured _____ 67 68 69 mon year Water level records avail. _____ 70

Description MP: spring Fed Pond Fed To Cistern above lsd below

Yield: _____ gpm 71 72 73 74 accuracy 75 Pumping period: _____ hours or days 76 77 Specific capacity: _____ gpm/ft. dd 78 79

Pumpage and other data available: _____ 80

Card 2

Coefficient trans: _____ gpd/ft 15 16 17 Coefficient storage: _____ 18 19 20 Coefficient perm.: _____ gpd/ft²

Aquifer, system or series _____ 21 _____ 22 _____ 23 _____ 24

Aquifer, units _____ 25 26 27 _____ 28 29 30 _____ 31 32 33

Aquifer, thickness: _____ feet 34 35 36 _____ 37 38 39 _____ 40 41 42 _____ 43 44 45

Aquifer, length of well open to: _____ feet 46 47 48 _____ 49 50 51 Aquifer, depth to top of: _____ lsd _____ feet 52 53 54 Aquifer, origin: _____

Aquifer, lithology of: _____ 55 56

Bedrock, system: _____ 57 Bedrock, formation: _____ 58 59 60 Bedrock, depth to: _____ lsd _____ feet 61 62 63

Surficial material: _____ lithology _____ infiltration characteristics _____ Log data avail: _____ 64

Quality of water data available: _____ 65 Temperature of water: _____ °F. _____ 66 67 Date sampled: _____ 68 69 70

Coefficient of leakage _____

THE FOLLOWING DATA ARE USED ON THE NATIONAL WELL SCHEDULE

Ownership category: (C) County, (F) Federal Gov't., (M) City, (N) Corp. or Co., (P) Private, (S) State Agency, (W) Water Dist. P 71

Method drilled: (A) Air, (B) bored, (C) cable, (D) dug, (V) driven, (H) hyd. rotary, (J) jetted, (R) rev. rotary, (T) trenching, (S) spring, _____ 72

Physiographic province: _____ 73 74 Section: _____


Drainage basin: _____ 75 76 Subbasin: _____ Depth to basement: _____ 77 78 79 source of data (basement) _____ 80

Quadrangle _____

Well no. 12-21E-14 A

not in computer file

any more data

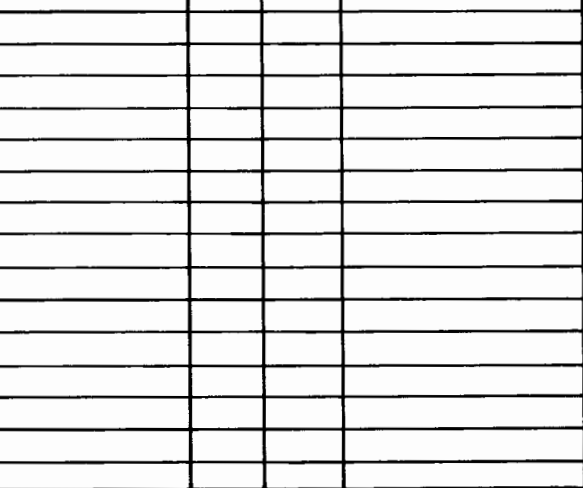

House

North
N

Trail's House

Pond

Trayder House
House

Foundation &
Floorboards

Pipe

C & R Rd