

Ralph Decker

1 mlt to 6 in wood

KANSAS WELL SCHEDULE

Card 1

Record by: Kleinhardt Date: 4-26 Project: top KC State: Kans County: Leav 52

Latitude: _____ Longitude: _____ Accuracy: _____ Owner's well no: _____

Location: SE SESE no. sec. 15 12 T. 21 N., R. 21 E. Well number: 1221E15000

Owner: Norman Montgomery

Owner: NORMAN MONTGOMERY Altitude: _____ Accuracy: _____

Driller: Jo Brien Date drilled: 66

Topography, well site: (D) 8 (F) 8 (L) 8 (R) 8 (S) 8 (T) 8 (U) 8 Spring; or depth of well: 45-6' Rock 100 3

Diameter: 8 inches 8 Depth cased: _____ Spring, or Csg. type: 4-2/5 Finish: _____ Lift & power: elec-jet A

Pump setting: _____ Use of well: Domestic, stock, irrigation, industrial, public supply, observation, none, test _____

Water level: 97 above lsd 97 3 073 Water level records avail. _____

Description MP: 6' Rock down to 45 and 8" steel to 100 ft

Yield: _____ gpm _____ Pumping period: _____ hours or days _____ Specific capacity: _____ gpm/ft. dd _____

Pumpage and other data available: _____

Card 2

Coefficient trans: _____ gpd/ft _____ Coefficient storage: _____ Coefficient perm.: _____ gpd/ft².

Aquifer, system or series _____

Aquifer, units _____

Aquifer, thickness: _____ feet _____ Aquifer, length of well open to: _____ feet _____ Aquifer, depth to top of: _____ feet _____ Aquifer, origin: _____

Aquifer, lithology of: _____

Bedrock, system: _____ Bedrock, formation: _____ Bedrock, depth to: _____ feet _____

Surficial material: _____ lithology _____ infiltration characteristics _____ Log data avail: _____

Quality of water data available: _____ Temperature of water: _____ °F. _____ Date sampled: _____

Coefficient of leakage _____

THE FOLLOWING DATA ARE USED ON THE NATIONAL WELL SCHEDULE

Ownership category: (C) County, (F) Federal Gov't., (M) City, (N) Corp. or Co., (P) Private, (S) State Agency, (W) Water Dist. P

Method drilled: (A) Air, (B) bored, (C) cable, (D) dug, (V) driven, (H) hyd. rotary, (J) jetted, (R) rev. rotary, (T) trenching, (S) spring, C

Physiographic province: _____ Section: _____

Drainage basin: _____ Subbasin: _____ Depth to basement: _____ source of data (basement) _____


Quadrangle Tor
Well no. 12-21E-15 ddd

North



K-32

Co Road

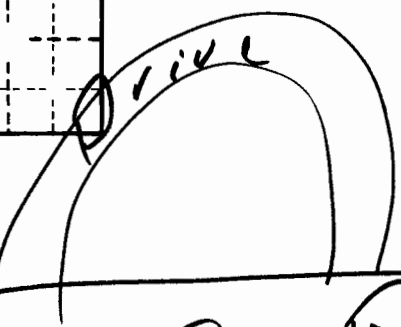

Co Road