

WATER WELL RECORD

DRILLERS LOG OF WELL

[illegible]

"To preserve water well information and to promote the conservation, protection, and development of ground-water resources."

Well Owner Mr. Shirk

Address 3 mi. West of Linwood, Ks.

Drilling Contractor Breuer Drilling Co

Basehor, Ks. P18-2210

Date Drilled 3-31-69

Method of Drilling Cable Tool
(Cable tool, rotary, reverse rotary, etc.)

Casing Schedule 37 ft. 6 1/2 steel
(Amount, Size, Setting—New, Used—Steel, Galv.—Gage or Weight)

Screen Data (if any): _____
(Length, Diameter, Slot Size, Setting)

Measured depth to water on completed well (Static Level) is

25 ft. below **land surface**
(Land Surface, Top of Casing, Etc.)

TESTED YIELD: 1/2 gallons per min
(Min., Hour)

as determined by Bailing
(Bailing, Test Pumping, Etc.)

DRAWDOWN: _____ ft. after _____ hrs.

pumping at _____ gal. per minute.

REMARKS: Well shot. approx. 560 gal.
Storage.

LOCATION OF WELL Topographic Sheet Tongue
[Show location in Section Plat] Elev. 930 ±

SW. $\frac{1}{4}$ SW $\frac{1}{4}$ Sec. 16

T. 12 S., R. 21 E. W

County Levy

$$BR = 9/16$$

10-57-5M SETS
905

KANSAS WELL SCHEDULE

Card 1

Record by Kleiss Date 4-26-77 Project top-KC State Kan County Leaw 52
 Latitude: _____ Longitude: _____ Accuracy: _____ Owner's well no: _____
 Location: SW SW no. sec. 16 T. 12 N., R. 21 E. Well number: 1221E16CC
 Owner: Fred Shirk address Linn
 Owner: FRED SHIRK Altitude: _____ Accuracy _____
 Driller: Bruce address _____ Date drilled: 3-31-67
 Topography, well site: (D) Draw, (F) flood plain, (L) lowland, (R) rolling, (S) slope, (T) terrace, (U) upland _____ Spring; or depth of well: 75 feet _____
 Diameter: 6 1/2 inches or feet _____ Depth cased: 37 feet _____ Spring, or Csg. type: sh Finish: _____ Lift & power: _____
 Pump setting: _____ Use of well: Domestic, stock, irrigation, industrial, public supply, observation, none, test _____
 Water level: 36.9 above lsd 369 M 14-26-77 073 Water level records avail. _____
 Description MP: Top Casing 1.0 above _____
 Yield: 52 gpm _____ Pumping period: _____ Specific capacity: _____
 Pumpage and other data available: _____



Card 2

Coefficient trans: _____ Coefficient storage: _____ Coefficient perm.: _____
 Aquifer, system or series _____
 Aquifer, units _____
 Aquifer, thickness: _____ feet _____ Aquifer, length of well open to: _____ feet _____ Aquifer, depth to top of: _____ feet _____ Aquifer, origin: _____
 Aquifer, lithology of: _____
 Bedrock, system: _____ Bedrock, formation: _____ Bedrock, depth to: _____ feet _____
 Surficial material: _____ lithology _____ Infiltration characteristics _____ Log data avail: Drillers log
 Quality of water data available: _____ Temperature of water: _____ °F. _____ Date sampled: _____
 Coefficient of leakage: _____

THE FOLLOWING DATA ARE USED ON THE NATIONAL WELL SCHEDULE

Ownership category: (C) County, (F) Federal Gov't., (M) City, (N) Corp. or Co., (P) Private, (S) State Agency, (W) Water Dist. _____
 Method drilled: (A) Air, (B) bored, (C) cable, (D) dug, (H) driven, (I) hyd. rotary, (J) jetted, (R) rev. rotary, (T) trenching, (S) spring, _____
 Physiographic province: _____ Section: _____
 Drainage basin: _____ Subbasin: _____ Depth to basement: _____ source of data (basement) _____

Quadrangle 7049
 Well no. 12-21E-16CC

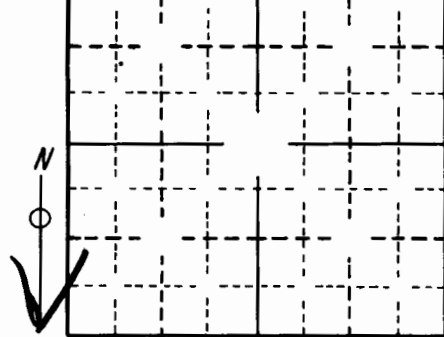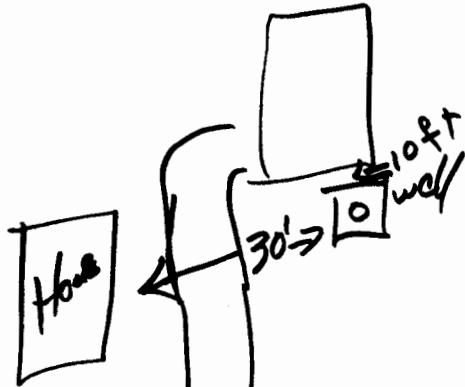

← North