

Installed new pump /
Recently and Figures
were written on Pump House
not in computer file

KANSAS WELL SCHEDULE

Card 1

Record by Klausner Date: 4-26 Project: Top-KC State: Kans County: Leaw 52
Latitude: _____ Longitude: _____ Accuracy: _____ Owner's well no: _____
Location: NW SW SW SW no. sec. 16 T. 12 N., R. 21 E. Well number: 1221E16CCCB
Owner: Harvey Eugene Jackson address _____
Owner: HARVEY EUGENE JACKSON Altitude: 935 Accuracy 3
Driller: _____ Date drilled: _____
Topography, well site: (D) Draw, (F) flood plain, (L) lowland, (R) rolling, (S) slope, (T) terrace, (U) upland, (V) Spring; or depth of well: 195 195 3
Diameter: 8 1/2 inches or feet 08 Depth cased: _____ Spring, or Csg. type: 5 Finish: _____ Lift & power: Sub 1/2 9
Pump setting: _____ Use of well: Domestic stock, irrigation, industrial, public supply, observation, none, test _____
Water level: 31 above lsd 31 3 073 Water level records avail. _____
Description MP: Top Casing 1.0 above _____
Yield: _____ Pumping period: _____ Specific capacity: _____
Pumpage and other data available: _____

Card 2

Coefficient trans: _____ Coefficient storage: _____ Coefficient perm.: _____ gpd/ft.
Aquifer, system or series: _____
Aquifer, units: _____
Aquifer, thickness: _____ Aquifer, length of well open to: _____ Aquifer, depth to top of: _____ Aquifer, origin: _____
Bedrock, system: _____ Bedrock, formation: _____ Bedrock, depth to: _____
Surficial material: _____ Log data avail: No Log
Quality of water data available: _____ Temperature of water: _____ Date sampled: _____
Coefficient of leakage: _____

THE FOLLOWING DATA ARE USED ON THE NATIONAL WELL SCHEDULE




Ownership category: (C) County, (F) Federal Gov't., (M) City, (N) Corp. or Co., (P) Private, (S) State Agency, (W) Water Dist. P
Method drilled: (A) Air, (B) bored, (C) cable, (D) dug, (V) driven, (H) hyd. rotary, (J) jetted, (R) rev. rotary, (T) trenching, (S) spring, _____
Physiographic province: _____ Section: _____
Drainage basin: _____ Subbasin: _____ Depth to basement: _____ source of data (basement) _____

Quadrangle Topog
Well no. 12-21E-16CCCB


Co Road

Set

Co Road

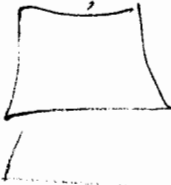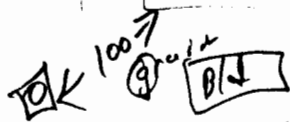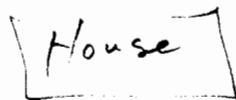

North

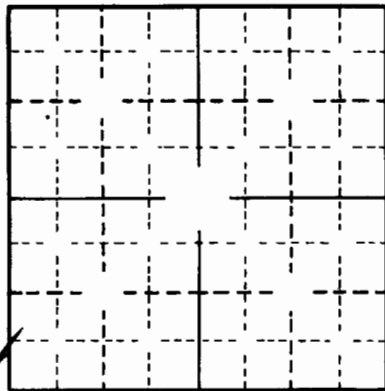

K-32
