WATER WELL RECORD Form WWC-5 KSA 82a-1212 ID No. _____

1 LOCATION OF WATER WELL: Fraction: NE ¼ NW ¼ NW ¼ | Section Number: 25 | Township Number: T 12 S | Range Number: R 22 E/W

County: Johnson

Distance and direction from nearest town or city street address of well if located within city?

0.2 Miles east of eastern termination of 79th street

2 WATER WELL OWNER: City of Olathe, Kansas

RR#, St. Address, Box # : P.O. Box 768

City, State, ZIP Code : Olathe, KS 66051

Board of Agriculture, Division of Water Resources Application Number:

3 LOCATE WELL'S LOCATION WITH AN "X" IN SECTION BOX:

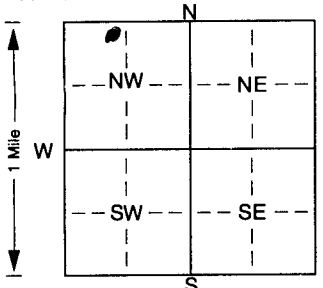

4 DEPTH OF COMPLETED WELL 65 ft. ELEVATION: 715

Depth(s) Groundwater Encountered 1. 32.6 ft. 2. ft. 3. ft.

WELL'S STATIC WATER LEVEL 32.6 ft. below land surface measured on mo/day/yr 10/29/02

Pump test data: Well water was 46.6 ft. after 7.2 hours pumping 3960 gpm

Est. Yield 4000 gpm: Well water was ft. after hours pumping gpm

Bore Hole Diameter 22.8 in. to 65 ft., and in. to ft.

WELL WATER TO BE USED AS: (5 Public water supply) 8 Air conditioning 11 Injection well

1 Domestic 3 Feedlot 6 Oil field water supply 9 Dewatering 12 Other (Specify below)

2 Irrigation 4 Industrial 7 Domestic (lawn & garden) 10 Monitoring well

Was a chemical/bacteriological sample submitted to Department? Yes ..... No ..... ; If yes, mo/day/yrs sample was submitted Water Well Disinfected? (Yes) No

5 TYPE OF BLANK CASING USED: 5 Wrought iron 8 Concrete tile CASING JOINTS: Glued ..... Clamped .....

1 Steel 3 RMP (SR) 6 Asbestos-Cement (9 Other (specify below)) Welded .....

2 PVC 4 ABS 7 Fiberglass Concrete, poured in place Threaded .....

Blank casing diameter 22.8 in. to 60 ft., Dia 23.4 in. to 65 ft., Dia in. to ft.

Casing height above land surface 14.4 in., weight 12,370 lbs./ft. Wall thickness or gauge No. 18" CONCRETE

TYPE OF SCREEN OR PERFORATION MATERIAL:

1 Steel (3 Stainless steel) 5 Fiberglass 7 PVC 10 Asbestos-cement

2 Brass 4 Galvanized steel 6 Concrete tile 8 RMP (SR) 11 Other (specify)

9 ABS 12 None used (open hole)

SCREEN OR PERFORATION OPENINGS ARE: 776'-12"0 5 Gauzed wrapped 8 Saw cut 11 None (open hole)

(1 Continuous slot) 3 Mill slot 6 Wire wrapped 9 Drilled holes

2 Louvered shutter 4 Key punched 7 Torch cut 10 Other (specify) ..... ft.

SCREEN-PERFORATED INTERVALS: From 58' ft. to 58' ft., From ft. to ft.

From ft. to ft., From ft. to ft.

GRAVEL PACK INTERVALS: From N/A ft. to ft., From ft. to ft.

From ft. to ft., From ft. to ft.

6 GROUT MATERIAL: 1 Neat cement (2 Cement grout) 3 Bentonite 4 Other .....

Grout Intervals: From 20 ft. to 0 ft., From ft. to ft., From ft. to ft.

What is the nearest source of possible contamination:

10 Livestock pens 14 Abandoned water well

1 Septic tank 4 Lateral lines 7 Pit privy 11 Fuel storage 15 Oil well/Gas well

2 Sewer lines 5 Cess pool 8 Sewage lagoon 12 Fertilizer storage (16 Other (specify below))

3 Watertight sewer lines 6 Seepage pit 9 Feedyard ~~13 Insecticide storage~~ Railroad

Direction from well? How many feet? approx. 1500'

FROM	TO	LITHOLOGIC LOG	FROM	TO	PLUGGING INTERVALS
0	5	Silt, clayey, dark brown, moist	44	63	Sand, medium to coarse, trace
5	15	Silt with fine sand, loose non-plastic			fine, occassional coarse gravel
15	21	Silt, clayey, grey brown stiff, medium plastic	63	66	Sand, fine to coarse and gravel, fine to coarse
21	28	Fine sand, trace silt dense, poorly graded	66	68	Shale, dark green
28	30	Clay, dark grey-brown, plastic			
30	35	Silt, some clay, some fine sand			
35	43	Sand, fine to coarse			
43	44	Clay, trace fine sand, trace silt			

7 CONTRACTOR'S OR LANDOWNER'S CERTIFICATION: This water well was (1) constructed, (2) reconstructed, or (3) plugged under my jurisdiction and was completed on (mo/day/year) 11/1/02 and this record is true to the best of my knowledge and belief. Kansas Water Well Contractor's Licence No. 696 This Water Well Record was completed on (mo/day/yr) 12/12/02 under the business name of Collector Wells International, Inc. by (signature)

INSTRUCTIONS: Use typewriter or ball point pen. *PLEASE PRESS FIRMLY* and *PRINT* clearly. Please fill in blanks, underline or circle the correct answers. Send top three copies to Kansas Department of Health and Environment, Bureau of Water, Topeka, Kansas 66620-0001. Telephone 785-296-5524. Send one to WATER WELL OWNER and retain one for your records. Fee of $5.00 for each constructed well.