

KANSAS WELL SCHEDULE

Card 1



5-113
Bott# 152Record by Meinhardt Date: 3-22-77 Project: Top-KC State: Ken County: Law 52

Latitude: deg min sec Longitude: deg min sec Accuracy: Owner's well no:

Location: SW NW NW no. sec. 5 T. 12 N. R. 22 E. Well number: 12 22 E-5 B B COwner: M. L. Oelschlaeger address Rt 1 LinwoodOwner: M. L. OELSCHLAEGGER Altitude: 1000± Accuracy: 3Driller: Braun Drilling Basin Date drilled: 4-17-65Topography, well site: (D) Draw, flood plain, lowland, rolling, slope, terrace, upland (U) Spring, or depth of well: 140 Accuracy: 3Diameter: 6 1/2 inches or feet: 0 6 Depth cased: 140 feet Spring, or Csg. type: 140 Finish: Sub-sleeve? Lift & power: 0Pump setting: X Use of well: Domestic stock, irrigation, industrial, public supply, observation, none, testWater level: 100 feet above/below 100 accuracy: 3 date measured: 67 month 68 year 69 Water level records avail.Description MP: Top of Basin Below Basin 2 ftYield: 4.5 accuracy: 45 R-31 Pumping period: hours or days 76 Specific capacity: 78 79Age and condition available: 00Coefficient trans: 15 16 17 Coefficient storage: 18 19 20 Coefficient permeability: 21 22 23 24 25 26 27 28 29 30 31 32 33 34 35 36 37 38 39 40 41 42 43 44 45Aquifer, system or series: 21 22 23 24Aquifer, unit: 25 26 27 28 29 30 31 32 33Aquifer, thickness: 34 35 36 37 38 39 40 41 42 43 44 45Aquifer, length of well open to: 46 47 48 49 50 51 52 53 54 55 56Aquifer, lithology of: 55 56Bedrock, system: 57 Bedrock, formation: 58 59 60 Bedrock, depth to: 61 62 63Surficial material: 64 Log data avail: Peatline LogQuality of water data available: 65 Temperature of water: 66 67 Date sampled: 68 69 70Coefficient of leakage: 71

THE FOLLOWING DATA ARE USED ON THE NATIONAL WELL SCHEDULE

Ownership category: (C) County, (F) Federal Gov't, (M) City, (N) Corp. or Co., (P) Private, (S) State Agency, (W) Water Dist. PMethod drilled: (A) Air, (B) bored, (C) cable, (D) dug, (H) driven, (I) hyd. rotary, (J) jetted, (R) rev. rotary, (T) trenching, (S) spring, CPhysiographic province: 73 74 Section: 75 76Drainage basin: 75 76 Subbasin: 77 78 79 Depth to basement: 80source of data (basement): 80Quadrangle: 12-22E-5 B B CWell no. 12-22E-5 B B C

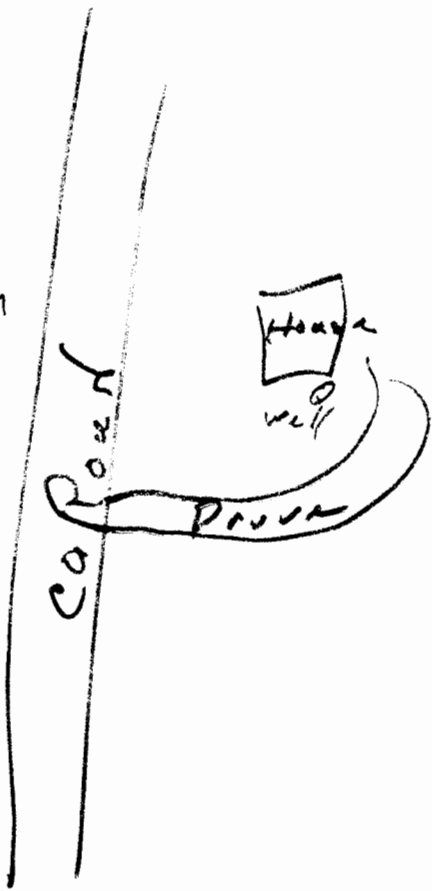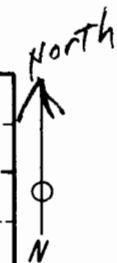

5' from House to well