

KANSAS WELL SCHEDULE

Card 1

Record by Harvard Date: 3-22-73 Project: Top KC State: Kans R County: Leav 52
2 3Latitude: _____ Longitude: _____ Accuracy: _____ Owner's well no: _____
deg min sec deg min secLocation: SE NE NE no. sec. 6 T. 12 N., R. 22 E. Well number: 1222E 6AAD
S. W. T R E-W sec 1 2 3 4 5 6 7 8 9 10 11 12 13 14 no.Owner: Arden E Shultz name addressOwner: ARDEN E SHULTZ Altitude: 980 Accuracy 3
15 16 17 18 19 20 21 22 23 24 25 26 27 28 29 30 31 32 33 34 35 36 37 38 lsd 39 40 41 42 43 44Driller: Brown Drilling name address Date drilled: 7-9-71Topography, well site: (D) Draw, (F) flood plain, (L) lowland, (R) rolling, (S) slope, (T) terrace, (U) upland 5 Spring, or depth of well: 98 feet 98 accuracy 3
45 lsd 46 47 48 49 50Diameter: 6 1/4 inches or feet 06 Depth cased: 98 feet 98 Spring, or Csg. type: steel Finish: _____ Lift & power: Sub-elec 0
51 52 53 54 55 56 57 58Pump setting: _____ feet 12.6 Use of well: Domestic stock, irrigation, industrial, public supply, observation, none, test _____ 1
4sd 59 60 61 62Water level: 12.6 above lsd 126 M 13-22-73 673 Water level records avail. _____
feet 63 64 65 accuracy 66 date measured 67 68 69 mon year 70Description MP: Top Casing 2 ft above lsd belowYield: 20 gpm 20 R 3 Pumping period: _____ hours or days _____ Specific capacity: _____ gpm/ft. dd _____
71 72 73 74 accuracy 75 76 77 78 79

Pumpage and other data available: _____ 80

Card 2

Coefficient trans: _____ gpd/ft 15 16 17 Coefficient storage: _____ 18 19 20 Coefficient perm.: _____ gpd/ft²
15 16 17 18 19 20

Aquifer, system or series _____ 21 _____ 22 _____ 23 _____ 24

Aquifer, units _____ 25 _____ 26 _____ 27 _____ 28 _____ 29 _____ 30 _____ 31 _____ 32 _____ 33

_____ 34 _____ 35 _____ 36 _____ 37 _____ 38 _____ 39 _____ 40 _____ 41 _____ 42 _____ 43 _____ 44 _____ 45

Aquifer, thickness: _____ feet 46 47 48 Aquifer, length of well open to: _____ feet 49 50 51 Aquifer, depth to top of: _____ feet 52 53 54 Aquifer, origin: _____
46 47 48 49 50 51 52 53 54

Aquifer, lithology of: _____ 55 56

Bedrock, system: _____ 57 Bedrock, formation: _____ 58 59 60 Bedrock, depth to: _____ feet 61 62 63
57 58 59 60 61 62 63Surficial material: _____ lithology _____ infiltration characteristics _____ Log data avail: Drilling log A
64Quality of water data available: _____ 65 Temperature of water: _____ °F. _____ Date sampled: _____ 68 69 70
65 66 67 68 69 70

Coefficient of leakage _____

THE FOLLOWING DATA ARE USED ON THE NATIONAL WELL SCHEDULE
Ownership category: (C) County, (F) Federal Gov't., (M) City, (N) Corp. or Co., (P) Private, (S) State Agency, (W) Water Dist. P
71Method drilled: (A) Air, (B) bored, (C) cased, (D) dug, (H) driven, (I) hyd. rotary, (J) jetted, (R) rev. rotary, (T) trenching, (S) spring, _____ C
72

Physiographic province: _____ 73 74 Section: _____

Drainage basin: _____ 75 76 Subbasin: _____ Depth to basement: _____ 77 78 79 source of data (basement) _____ 80
75 76 77 78 79 80


Quadrangle _____

Well no. 12-22E-6AAD



Creek

10 ft lower than house elev

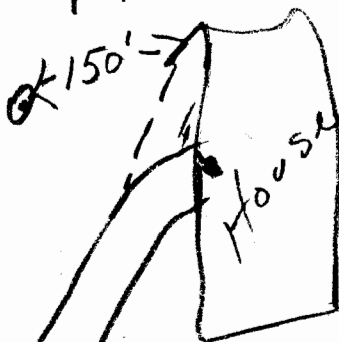

C. Road