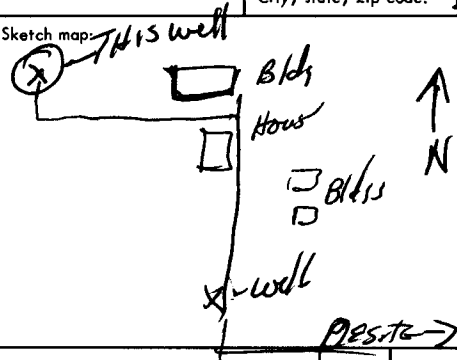


USE TYPEWRITER OR BALL POINT PEN-PRESS FIRMLY, PRINT CLEARLY.

WATER WELL RECORD
KSA 82a-1201-1215

DBB

Kansas Department of Health and Environment-Division of Environment
(Water well Contractors)
Topeka, Kansas 66620

1. Location of well:		County Johnson	Fraction NW NW NE 1/4 SE 1/4	Section number 19	Township number T 12 S R 22 E E/W	Range number
2. Distance and direction from nearest town or city: 4 mi. west De Soto, Kansas			3. Owner of well: Riverview Farms			
Street address of well location if in city:			R.R. or street:			
			City, state, zip code: De Soto, Kansas 66018			
4. Locate with "X" in section below:		Sketch map: <i>THIS well</i>		6. Bore hole dia. 30 in. Completion date 7/77		
N				Well depth 54 ft.		
W				7. <input type="checkbox"/> Cable tool <input type="checkbox"/> Rotary <input type="checkbox"/> Driven <input type="checkbox"/> Dug		
E				<input type="checkbox"/> Hollow rod <input type="checkbox"/> Jetted <input checked="" type="checkbox"/> Bored <input type="checkbox"/> Reverse rotary		
S				8. Use: <input type="checkbox"/> Domestic <input type="checkbox"/> Public supply <input type="checkbox"/> Industry		
1 Mile				<input checked="" type="checkbox"/> Irrigation <input type="checkbox"/> Air conditioning <input type="checkbox"/> Stock		
				<input type="checkbox"/> Lawn <input type="checkbox"/> Oil field water <input type="checkbox"/> Other		
				9. Casing: Material steel Height: Above or below		
				Threaded <input type="checkbox"/> Welded <input checked="" type="checkbox"/> Surface 12 in.		
				RMP <input type="checkbox"/> PVC <input type="checkbox"/> Weight _____ lbs./ft.		
				Dia. 12 in. to 34 ft. depth Wall Thickness: inches or		
				Dia. _____ in. to _____ ft. depth gage No. _____		
5. Type and color of material		Well # 2 S.W. Well		10. Screen: Manufacturer's name		
Drift				Johnson		
Fine Sand				Type Irrigator Dia. 12"		
Fine Sand and Gravel				Slot/gauze 100 Length 20'		
Coarse Sand & Gravel				Set between 54 ft. and 55 ft.		
Limestone				_____ ft. and _____ ft.		
				Gravel pack? yes Size range of material 1/8		
				11. Static water level: _____ mg./day/yr.		
				8 ft. below land surface Date 7/77		
				12. Pumping level below land surfaces:		
				_____ ft. after _____ hrs. pumping _____ g.p.m.		
				_____ ft. after _____ hrs. pumping _____ g.p.m.		
				Estimated maximum yield 800 g.p.m.		
				13. Water sample submitted: _____ mo./day/yr.		
				Yes <input checked="" type="checkbox"/> No <input type="checkbox"/> Date _____		
				14. Well head completion:		
				<input type="checkbox"/> Pitless adapter 12 inches above grade		
				15. Well grouted? yes		
				With: <input type="checkbox"/> Neat cement <input type="checkbox"/> Bentonite <input checked="" type="checkbox"/> Concrete		
				Depth: From 2 ft. to 10 ft.		
				16. Nearest source of possible contamination:		
				ft. 800 Direction N Type river		
				Well disinfected upon completion? _____ Yes _____ No		
				17. Pump: _____ Not installed		
				Manufacturer's name Worthington		
				Model number 12M90 HP 100 Volts _____		
				Length of drop pipe 40 ft. capacity 900 g.p.m.		
				Type:		
				<input type="checkbox"/> Submersible <input checked="" type="checkbox"/> Turbine		
				<input type="checkbox"/> Jet <input type="checkbox"/> Reciprocating		
				<input type="checkbox"/> Centrifugal <input type="checkbox"/> Other		
18. Elevation:		19. Remarks:		20. Water well contractor's certification:		
790' km				This well was drilled under my jurisdiction and this report is true to the best of my knowledge and belief.		
Topography:				Cullum & Brown, Inc 121		
<input type="checkbox"/> Hill				Business name _____ License No. _____		
<input type="checkbox"/> Slope				Address N. K. C., MO. 64116		
<input type="checkbox"/> Upland				Signed _____ Date _____		
<input checked="" type="checkbox"/> Valley				Authorized representative _____		

Forward the white, blue and pink copies to the Department of Health and Environment

Form WWC-5

T 12 S R 22 E E/W
 19
 NW 1/4
 NE 1/4
 SE 1/4