


1 LOCATION OF WATER WELL: Fraction NE 1/4 NW 1/4 SE 1/4 Section Number 6 Township Number T 12 S Range Number R 22 E
 County: Leavenworth
 Distance and direction from nearest town or city street address of well if located within city?

2 1/2 Miles North East of Linwood

2 WATER WELL OWNER: Wayne Eldridge c/o Mabelle Restaurant
 RR#, St. Address, Box #: RR #1
 City, State, ZIP Code: Linwood, Kansas 66052
 Board of Agriculture, Division of Water Resources
 Application Number: 16973

3 LOCATE WELL'S LOCATION WITH AN "X" IN SECTION BOX: 4 DEPTH OF COMPLETED WELL 100 ft. ELEVATION: 960

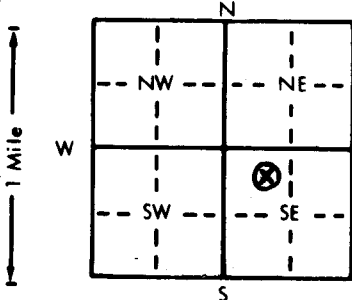

Depth(s) Groundwater Encountered 1 60 ft. 2. 50 ft. 3. 2-12-83 ft.

WELL'S STATIC WATER LEVEL 50 ft. below land surface measured on mo/day/yr 2-12-83

Pump test data: Well water was 6 ft. after 6 hours pumping 6 gpm

Est. Yield 6 gpm: Well water was 6 ft. after 6 hours pumping 6 gpm

Bore Hole Diameter 10 in. to 10 ft., and 10 in. to 10 ft.

WELL WATER TO BE USED AS: 5 Public water supply 8 Air conditioning 11 Injection well

1 Domestic 3 Feedlot 6 Oil field water supply 9 Dewatering 12 Other (Specify below)

2 Irrigation 4 Industrial 7 Lawn and garden only 10 Observation well

Was a chemical/bacteriological sample submitted to Department? Yes X No If yes, mo/day/yr sample was submitted

Water Well Disinfected? Yes No

5 TYPE OF BLANK CASING USED: 5 Wrought iron 8 Concrete tile CASING JOINTS: Glued X Clamped

1 Steel 3 RMP (SR) 6 Asbestos-Cement 9 Other (specify below) Welded

2 PVC 4 ABS 7 Fiberglass Threaded

Blank casing diameter 5 in. to 100 ft., Dia in. to ft., Dia in. to ft.

Casing height above land surface 24 in., weight Monitor Pitless Unit lbs./ft. Wall thickness or gauge No.

TYPE OF SCREEN OR PERFORATION MATERIAL: 7 PVC 10 Asbestos-cement

1 Steel 3 Stainless steel 5 Fiberglass 8 RMP (SR) 11 Other (specify)

2 Brass 4 Galvanized steel 6 Concrete tile 9 ABS 12 None used (open hole)

SCREEN OR PERFORATION OPENINGS ARE: 5 Gauzed wrapped 8 Saw cut 11 None (open hole)

1 Continuous slot 3 Mill slot 6 Wire wrapped 9 Drilled holes

2 Louvered shutter 4 Key punched 7 Torch cut 10 Other (specify)

SCREEN-PERFORATED INTERVALS: From 40 ft. to 90 ft., From ft. to ft.

From ft. to ft., From ft. to ft.

GRAVEL PACK INTERVALS: From 26 ft. to 100 ft., From ft. to ft.

From ft. to ft., From ft. to ft.

6 GROUT MATERIAL: 1 Neat cement 2 Cement grout 3 Bentonite 4 Other

Grout Intervals: From 4 ft. to 26 ft., From ft. to ft., From ft. to ft.

What is the nearest source of possible contamination: 10 Livestock pens 14 Abandoned water well

1 Septic tank 4 Lateral lines 7 Pit privy 11 Fuel storage 15 Oil well/Gas well

2 Sewer lines 5 Cess pool 8 Sewage lagoon 12 Fertilizer storage 16 Other (specify below)

3 Watertight sewer lines 6 Seepage pit 9 Feedyard 13 Insecticide storage

Direction from well? South How many feet? 220'

FROM TO LITHOLOGIC LOG FROM TO LITHOLOGIC LOG

0 2 surface

2 20 clay Brown

20 23 shale Black

23 46 shale grey

46 63 sandstone

63 65 limestone grey

65 88 shale grey

88 91 limestone grey

91 96 shale grey

96 98 limestone grey

98 100 shale grey

100 limestone grey

7 CONTRACTOR'S OR LANDOWNER'S CERTIFICATION: This water well was (1) constructed, (2) reconstructed, or (3) plugged under my jurisdiction and was completed on (mo/day/year) 2-14-83 and this record is true to the best of my knowledge and belief. Kansas

Water Well Contractor's License No. 240 This Water Well Record was completed on (mo/day/yr) 3-8-83

under the business name of F.E. Young Drilling by (signature) David Young

INSTRUCTIONS: Use typewriter or ball point pen. PLEASE PRESS FIRMLY and PRINT clearly. Please fill in blanks, underline or circle the correct answers. Send top

three copies to Kansas Department of Health and Environment, Division of Environment, Environmental Geology Section, Topeka, KS 66620. Send one to WATER WELL

OWNER and retain one for your records.