WATER WELL RECORD Form WWC-5 KSA 82a-1212

LOCATION OF WATER WELL: County: LEAV.	Fraction SE ¼ SE ¼ SE ¼	Section Number 6	Township Number T 12 S	Range Number R 22 (E)W

Distance and direction from nearest town or city street address of well if located within city? 2½ miles ~~E~~ N OF LINWOOD

WATER WELL OWNER: WAYNE Eldridge
RR#, St. Address, Box # : RR #1 Box 154E
City, State, ZIP Code : LINWOOD, KS 66052

Board of Agriculture, Division of Water Resources Application Number: NONE

LOCATE WELL'S LOCATION WITH AN "X" IN SECTION BOX:

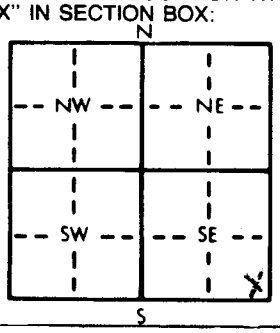

4 DEPTH OF COMPLETED WELL 85 ft. ELEVATION:

Depth(s) Groundwater Encountered 1. 49' ft. 2. — ft. 3. — ft.

WELL'S STATIC WATER LEVEL 40' ft. below land surface measured on mo/day/yr 1-12-82

Pump test data: Well water was — ft. after — hours pumping — gpm

Est. Yield 10 gpm: Well water was — ft. after — hours pumping — gpm

Bore Hole Diameter 8" in. to 85' ft., and — in. to — ft.

WELL WATER TO BE USED AS: (5) Public water supply 8 Air conditioning 11 Injection well
1 Domestic 3 Feedlot 6 Oil field water supply 9 Dewatering 12 Other (Specify below)
2 Irrigation 4 Industrial 7 Lawn and garden only 10 Observation well

Was a chemical/bacteriological sample submitted to Department? Yes ..... No X ; If yes, mo/day/yr sample was submitted —

Water Well Disinfected? (Yes) BLEACH No —

TYPE OF BLANK CASING USED: 5 Wrought iron 8 Concrete tile CASING JOINTS: Glued Clamped
1 Steel (3) RMP (SR) 6 Asbestos-Cement 9 Other (specify below) Welded
2 PVC 4 ABS 7 Fiberglass Threaded

Blank casing diameter 5" in. to 45 ft., Dia — in. to — ft., Dia — in. to — ft.

Casing height above land surface 18" in., weight lbs./ft. Wall thickness or gauge No. ¼"

TYPE OF SCREEN OR PERFORATION MATERIAL: 7 PVC 10 Asbestos-cement
1 Steel 3 Stainless steel 5 Fiberglass (8) RMP (SR) 11 Other (specify)
2 Brass 4 Galvanized steel 6 Concrete tile 9 ABS 12 None used (open hole)

SCREEN OR PERFORATION OPENINGS ARE: 5 Gauzed wrapped (8) Saw cut 11 None (open hole)
1 Continuous slot 3 Mill slot 6 Wire wrapped 9 Drilled holes
2 Louvered shutter 4 Key punched 7 Torch cut 10 Other (specify)

SCREEN-PERFORATED INTERVALS: From 45 ft. to 84 ft., From — ft. to — ft.
From — ft. to — ft., From — ft. to — ft.

GRAVEL PACK INTERVALS: From 85 ft. to 15 ft., From — ft. to — ft.
From — ft. to — ft., From — ft. to — ft.

GROUT MATERIAL: (1) Neat cement 2 Cement grout 3 Bentonite 4 Other

Grout Intervals: From 4 ft. to 15 ft., From — ft. to — ft., From — ft. to — ft.

What is the nearest source of possible contamination:
1 Septic tank 4 Lateral lines 7 Pit privy 10 Livestock pens 14 Abandoned water well
2 Sewer lines 5 Cess pool 8 Sewage lagoon 11 Fuel storage 15 Oil well/Gas well
3 Watertight sewer lines 6 Seepage pit 9 Feedyard 12 Fertilizer storage 16 Other (specify below)
13 Insecticide storage

Direction from well? West How many feet?

FROM	TO	LITHOLOGIC LOG	FROM	TO	LITHOLOGIC LOG
0	2	SURFACE			
2	20	BROWN CLAY			
20	23	Shale			
23	46	Grey Shale			
46	63	BROWN SANDSTONE			
63	65	LIME			
65	85	Shale T.D.			

CONTRACTOR'S OR LANDOWNER'S CERTIFICATION: This water well was (1) constructed, (2) reconstructed, or (3) plugged under my jurisdiction and was completed on (mo/day/year) 1-12-82 and this record is true to the best of my knowledge and belief. Kansas Water Well Contractor's License No. 350 This Water Well Record was completed on (mo/day/yr) 2-2-84
under the business name of A. G. GLAZE DRLG. INC. by (signature) [signature]

INSTRUCTIONS: Use typewriter or ball point pen, *PLEASE PRESS FIRMLY* and *PRINT* clearly. Please fill in blanks, underline or circle the correct answers. Send top three copies to Kansas Department of Health and Environment, Division of Environment, Environmental Geology Section, Topeka, KS 66620. Send one to WATER WELL OWNER and retain one for your records.