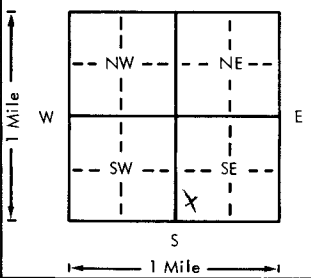


WATER WELL RECORD
KSA 82a-1201-1215

1. Location of well:	County Leavenworth	Fraction SW 1/4 SE 1/4 SE 1/4	Section number 6	Township number T 12 South S	Range number R 22 East 9W																														
2. Distance and direction from nearest town or city: 2 1/2 Miles N.E. of Linwood, Ks.		3. Owner of well: Mr. Bill Vitt R.R. or street: 559 Blue Grass Drive City, state, zip code: Bonner Springs, Kansas																																	
4. Locate with "X" in section below: <div style="text-align: center;">  </div>			Sketch map:																																
5. Type and color of material <table border="1" style="width:100%; border-collapse: collapse;"> <thead> <tr> <th></th> <th>From</th> <th>To</th> </tr> </thead> <tbody> <tr><td>Sandy Clay</td><td>0</td><td>10</td></tr> <tr><td>Sandstone</td><td>10</td><td>38</td></tr> <tr><td>Shale</td><td>38</td><td>41</td></tr> <tr><td>Lime</td><td>41</td><td>71</td></tr> <tr><td>Shale</td><td>71</td><td>77</td></tr> <tr><td>Lime</td><td>77</td><td>81</td></tr> <tr><td>Shale</td><td>81</td><td>103</td></tr> <tr><td>Lime</td><td>103</td><td>121</td></tr> <tr><td>Shale</td><td>121</td><td>125</td></tr> </tbody> </table>				From	To	Sandy Clay	0	10	Sandstone	10	38	Shale	38	41	Lime	41	71	Shale	71	77	Lime	77	81	Shale	81	103	Lime	103	121	Shale	121	125	6. Bore hole dia. 8 in. Completion date 8/3/77 Well depth 125 ft.		
				From	To																														
			Sandy Clay	0	10																														
			Sandstone	10	38																														
			Shale	38	41																														
			Lime	41	71																														
			Shale	71	77																														
			Lime	77	81																														
			Shale	81	103																														
			Lime	103	121																														
Shale	121	125																																	
7. <input checked="" type="checkbox"/> Cable tool <input checked="" type="checkbox"/> Rotary <input type="checkbox"/> Driven <input type="checkbox"/> Dug <input type="checkbox"/> Hollow rod <input type="checkbox"/> Jetted <input type="checkbox"/> Bored <input type="checkbox"/> Reverse rotary																																			
8. Use: <input checked="" type="checkbox"/> Domestic <input type="checkbox"/> Public supply <input type="checkbox"/> Industry <input type="checkbox"/> Irrigation <input type="checkbox"/> Air conditioning <input type="checkbox"/> Stock <input type="checkbox"/> Lawn <input type="checkbox"/> Oil field water <input type="checkbox"/> Other																																			
9. Casing: Material Pl. Height: Above or XXXX Threaded <input type="checkbox"/> Welded <input checked="" type="checkbox"/> Surface 18 in. RMP <input type="checkbox"/> PVC <input checked="" type="checkbox"/> Weight <input type="checkbox"/> lbs./ft. Dia. 5 in. to 125 ft. depth Wall Thickness: inches or Dia. <input type="checkbox"/> in. to <input type="checkbox"/> ft. depth gage No. .265																																			
10. Screen: Manufacturer's name Vin plex Type Slotted Dia. 5 " Slot/gauze .06 1/16 Length XXXX 10ft. Set between 28 ft. and 28-38 ft. ft. and <input type="checkbox"/> ft. Gravel pack? <input checked="" type="checkbox"/> Size range of material 1/8 to 1/4																																			
11. Static water level: <input type="checkbox"/> mo./day/yr. 17 ft. below land surface Date 8/3/77																																			
12. Pumping level below land surfaces: ft. after <input type="checkbox"/> hrs. pumping <input type="checkbox"/> g.p.m. ft. after <input type="checkbox"/> hrs. pumping <input type="checkbox"/> g.p.m. Estimated maximum yield 4 g.p.m.																																			
13. Water sample submitted: <input type="checkbox"/> mo./day/yr. Yes <input checked="" type="checkbox"/> No <input type="checkbox"/> Date <input type="checkbox"/>																																			
14. Well head completion: <input checked="" type="checkbox"/> Pitless adapter 18 Inches above grade																																			
15. Well grouted? <input checked="" type="checkbox"/> With: <input checked="" type="checkbox"/> Neat cement <input type="checkbox"/> Bentonite <input type="checkbox"/> Concrete Depth: From 3 ft. to 12 ft.																																			
16. Nearest source of possible contamination: ft. 150 Direction N Type Septic Well disinfected upon completion? <input checked="" type="checkbox"/> Yes <input type="checkbox"/> No																																			
17. Pump: <input type="checkbox"/> Not installed Manufacturer's name Jacuzzi Model number 554B HP 1/2 Volts 230 Length of drop pipe 115 ft. capacity 10 g.p.m. Type: <input checked="" type="checkbox"/> Submersible <input type="checkbox"/> Turbine <input type="checkbox"/> Jet <input type="checkbox"/> Reciprocating <input type="checkbox"/> Centrifugal <input type="checkbox"/> Other																																			
18. Elevation: 970 Topography: <input type="checkbox"/> Hill <input type="checkbox"/> Slope <input type="checkbox"/> Upland <input type="checkbox"/> Valley			19. Remarks: 922' from map																																
20. Water well contractor's certification: This well was drilled under my jurisdiction and this report is true to the best of my knowledge and belief. Breuer, Inc. 174 Business name Box 117, Basehor, Ks. License No. Address Box 117, Basehor, Ks. Signed Joseph D. Breuer Date 8/3/77 Authorized representative																																			

1
2
