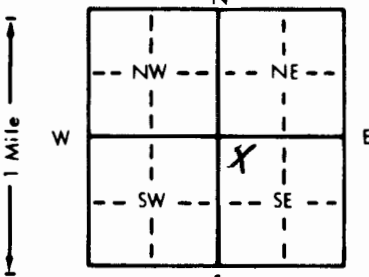


1 LOCATION OF WATER WELL: County: LEAVENWORTH Fraction NW 1/4 NW 1/4 SE 1/4 Section Number 7 Township Number T 12 S Range Number R 22 E/W

Distance and direction from nearest town or city street address of well if located within city?

1 3/4 MILES N OF LINWOOD KS

2 WATER WELL OWNER: PAT CULTER RR#, St. Address, Box #: RR 1 BOX 266 City, State, ZIP Code: LINWOOD KS 66052	Board of Agriculture, Division of Water Resources Application Number:
---	--

3 LOCATE WELL'S LOCATION WITH AN "X" IN SECTION BOX: 	4 DEPTH OF COMPLETED WELL: 120 ft. ELEVATION: Depth(s) Groundwater Encountered 1. 30 ft. 2. ft. 3. ft. WELL'S STATIC WATER LEVEL 38 ft. below land surface measured on mo/day/yr 9/3/90 Pump test data: Well water was ft. after hours pumping gpm Est. Yield 2 gpm Well water was ft. after hours pumping gpm Bore Hole Diameter 8 1/2 in. to 120 ft. and in. to ft. WELL WATER TO BE USED AS: 1 Domestic 3 Feedlot 6 Oil field water supply 9 Dewatering 12 Other (Specify below) 2 Irrigation 4 Industrial 7 Lawn and garden only 10 Monitoring well Was a chemical/bacteriological sample submitted to Department? Yes No X ; If yes, mo/day/yr sample was submitted Water Well Disinfected? Yes X No
--	--

5 TYPE OF BLANK CASING USED: 1 Steel 3 RMP (SR) 5 Wrought iron 8 Concrete tile CASING JOINTS: Glued X Clamped 2 PVC 4 ABS 6 Asbestos-Cement 9 Other (specify below) Welded 7 Fiberglass Threaded Blank casing diameter 5 in. to 35 ft. Dia. in. to ft. Dia. in. to ft. Casing height above land surface 18 in., weight 1.5 lbs./ft. Wall thickness or gauge No. SAR 26
TYPE OF SCREEN OR PERFORATION MATERIAL: 1 Steel 3 Stainless steel 5 Fiberglass 8 RMP (SR) 10 Asbestos-cement 2 Brass 4 Galvanized steel 6 Concrete tile 9 ABS 11 Other (specify) SAW SLOT 12 None used (open hole)
SCREEN OR PERFORATION OPENINGS ARE: 1 Continuous slot 3 Mill slot 5 Gauzed wrapped 8 Saw cut 11 None (open hole) 2 Louvered shutter 4 Key punched 6 Wire wrapped 9 Drilled holes 7 Torch cut 10 Other (specify)
SCREEN-PERFORATED INTERVALS: From 120 ft. to 35 ft. From ft. to ft. From ft. to ft. From ft. to ft. GRAVEL PACK INTERVALS: From 120 ft. to 30 ft. From ft. to ft. From ft. to ft. From ft. to ft.

6 GROUT MATERIAL: 1 Neat cement 2 Cement grout 3 Bentonite 4 Other
Grout Intervals: From 30 ft. to 4 ft. From ft. to ft. From ft. to ft.
What is the nearest source of possible contamination: 1 Septic tank 4 Lateral lines 7 Pit privy 10 Livestock pens 14 Abandoned water well 2 Sewer lines 5 Cess pool 8 Sewage lagoon 11 Fuel storage 15 Oil well/Gas well 3 Watertight sewer lines 6 Seepage pit 9 Feedyard 12 Fertilizer storage 16 Other (specify below) 13 Insecticide storage
Direction from well? How many feet? 200 feet

FROM	TO	LITHOLOGIC LOG	FROM	TO	PLUGGING INTERVALS
0	3	SURFACE			
3	50	SANDSTONE BROWN			
50	55	LIME			
55	61	SHALE			
61	65	LIME			
65	68	SHALE			
68	88	LIME			
88	94	SHALE DARK			
94	98	LIME			
98	118	SHALE			
118	121	LIME			

7 CONTRACTOR'S OR LANDOWNER'S CERTIFICATION: This water well was (1) constructed, (2) reconstructed, or (3) plugged under my jurisdiction and was completed on (mo/day/year) 9/7/90 and this record is true to the best of my knowledge and belief. Kansas Water Well Contractor's License No. 240 This Water Well Record was completed on (mo/day/yr) 9/17/90 under the business name of FE. YOUNG DRILLING CO by (signature) <i>Red Young</i>

INSTRUCTIONS: Use typewriter or ball point pen. PLEASE PRESS FIRMLY and PRINT clearly. Please fill in blanks, underline or circle the correct answers. Send up three copies to Kansas Department of Health and Environment, Bureau of Water, Topeka, Kansas 66620-7320. Telephone: 913-296-5545. Send one to WATER WELL OWNER and retain one for your records.