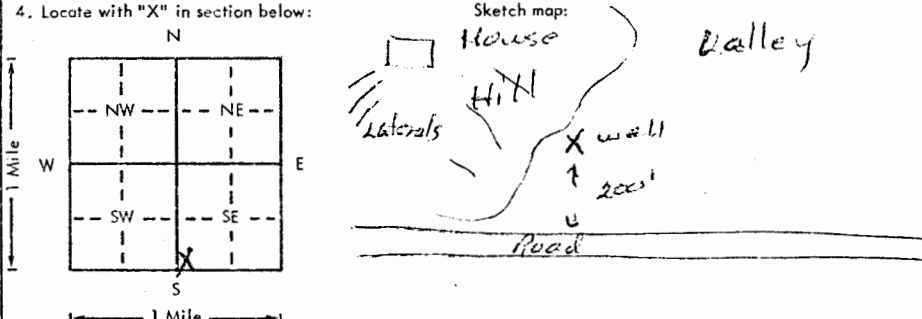


USE TYPEWRITER OR BALL
POINT PEN-PRESS FIRMLY,
PRINT CLEARLY.

WATER WELL RECORD
KSA 82a-1201-1215

Kansas Department of Health and
Environment-Division of Environment
(Water well Contractors)
Topeka, Kansas 66620

1. Location of well:		County <u>Leavenworth</u>	Fraction <u>NW 1/4 SW 1/4 SE 1/4</u>	Section number <u>17 18</u>	Township number <u>T 12 S</u>	Range number <u>R 22 E/W</u>
2. Distance and direction from nearest town or city: <u>2 1/2 East</u> Street address of well location if in city: <u>Linnwood</u>				3. Owner of well: <u>Percy Mosher Mosser</u> R.R. or street: <u>RR</u> City, state, zip code: <u>Linnwood, KS 66601</u>		
4. Locate with "X" in section below: 				6. Bore hole dia. <u>10</u> in. Completion date <u>5-6-77</u> Well depth <u>44</u> ft.		
5. Type and color of material				7. ☒ Cable tool ☒ Rotary ☐ Driven ☐ Dug ☐ Hollow rod ☐ Jetted ☐ Bored ☐ Reverse rotary		
				8. Use: ☒ Domestic ☐ Public supply ☐ Industry ☐ Irrigation ☐ Air conditioning ☐ Stock ☐ Lawn ☐ Oil field water ☐ Other		
				9. Casing: Material <u>PVC</u> Height <u>(Above or below)</u> Threaded ☐ Welded ☐ Surface <u>2.4</u> in. RMP ☐ PVC <u>Clear</u> Weight <u>2.74</u> lbs./ft. Dia. <u>5</u> in. to <u>44</u> ft. depth Wall Thickness: inches or Dia. <u>5</u> in. to <u>44</u> ft. depth gage No. <u>258</u>		
				10. Screen: Manufacturer's name <u>Flowline</u> Type <u>PVC</u> Dia. <u>5"</u> Slot/gauze <u>0.30</u> Length <u>10'</u> Set between <u>34</u> ft. and <u>44</u> ft. Gravel pack? <u>Yes</u> Size range of material <u>0.30-0.50</u>		
				11. Static water level: <u>20</u> ft. below land surface Date <u>5-6-77</u>		
				12. Pumping level below land surfaces: <u>Air Test</u> <u>20</u> ft. after <u>0</u> hrs. pumping <u>0</u> g.p.m. <u>33</u> ft. after <u>0</u> hrs. pumping <u>0</u> g.p.m. Estimated maximum yield <u>15</u> g.p.m.		
				13. Water sample submitted: <u>Yes</u> ☒ No ☐ Date <u>5-6-77</u>		
				14. Well head completion: <u>Cap Top</u> <u>Pitless adapter</u> <u>24</u> inches above grade		
				15. Well grouted? <u>Yes</u> With: ☒ Neat cement ☐ Bentonite ☐ Concrete Depth: From <u>0</u> ft. to <u>10</u> ft.		
				16. Nearest source of possible contamination: ft. <u>500</u> Direction <u>NW</u> Type <u>Lateral</u> Well disinfected upon completion? ☒ Yes ☐ No		
				17. Pump: ☒ Not installed Manufacturer's name _____ Model number _____ HP _____ Volts _____ Length of drop pipe _____ ft. capacity _____ g.p.m. Type: _____ ☐ Submersible ☐ Turbine ☐ Jet ☐ Reciprocating ☐ Centrifugal ☐ Other		
18. Elevation: <u>795</u> Topography: <u>Hill</u> ☐ Hill ☐ Slope ☐ Upland ☒ Valley				19. Remarks: <u>Owner will construct cement slab around well</u>		
				20. Water well contractor's certification: This well was drilled under my jurisdiction and this report is true to the best of my knowledge and belief. <u>STRADER D&S Co Inc.</u> 183. Business name _____ License No. _____ Address <u>RT 1 Holton, KS</u> Signed <u>Dale Polver</u> Date <u>5-8-77</u> Authorized representative		

Forward the white, blue and pink copies to the Department of Health and Environment

Form WWC-5