

KANSAS WELL SCHEDULE

Card 1

Not entered
in computer
Be

Record by: Kleinschmidt Date: 5-4 Project: Top-KC State: Kan K County: Leav 52
 1 2 3

Latitude: _____ deg min sec Longitude: _____ deg min sec Accuracy: _____ Owner's well no: _____

Location: NW 1/4 SW 1/4 no. sec. 3 T. 12 N., R. 22 E. Well number: 1222E 3CCB
 4 5 6 7 8 9 10 11 12 13 14
 T R E-W sec 1 2 3 4 no.

Owner: John Hylton name address

Owner: JOHN HYLTON 15 16 17 18 19 20 21 22 23 24 25 26 27 28 29 30 31 32 33 34 35 36 37 38 Altitude: 875 875 Accuracy 3
 1 2 3 4 5 6 7 8 9 10 11 12 13 14 15 16 17 18 19 20 21 22 23 24 25 26 27 28 29 30 31 32 33 34 35 36 37 38 39 40 41 42 43 44

Driller: _____ name address Date drilled: 20 yrs

Topography, well site: (D) Draw, flood plain, (F) lowland, (L) rolling, (R) slope, (S) terrace, (T) upland, (U) Spring, or depth of well: 14.5 145 1 16.0
 45 46 47 48 49 accuracy 50 75

Diameter: 4'0 28 Depth cased: 14.5 45 Spring, or Csg. type: Rock Finish: _____ Lift & power: _____
 51 52 53 54 55 56 57 58 14.0

Pump setting: _____ feet 59 60 61 Use of well: Domestic, stock, irrigation, industrial, public supply, observation, none, test _____ 62

Water level: 3.6 above 63 64 65 accuracy 66 5-4 E73 Water level records avail. _____ 70
 67 68 69 mon year

Description MP: Top Concrete Slab 1.5' above above 71 72 73 74 accuracy 75 Have to haul some Summers

Yield: _____ gpm 71 72 73 74 accuracy 75 Pumping period: _____ hours or days 76 77 Specific capacity: _____ gpm/ft. dd 78 79

Pumpage and other data available: _____ 80

Card 2

Coefficient trans: _____ gpd/ft 15 16 17 Coefficient storage: _____ 18 19 20 Coefficient perm.: _____ gpd/ft²

Aquifer, system or series _____ 21 22 23 24

Aquifer, units _____ 25 26 27 28 29 30 31 32 33

Aquifer, thickness: _____ feet 34 35 36 37 38 39 40 41 42 43 44 45

Aquifer, length of well open to: _____ feet 46 47 48 49 50 51 Aquifer, depth to top of: _____ feet 52 53 54 Aquifer, origin: _____

Aquifer, lithology of: _____ 55 56 Bedrock, system: _____ 57 Bedrock, formation: _____ 58 59 60 Bedrock, depth to: _____ feet 61 62 63

Surficial material: _____ lithology infiltration characteristics Log data avail: no log _____ 64

Quality of water data available: _____ 65 Temperature of water: _____ °F. 66 67 Date sampled: _____ 68 69 70

Coefficient of leakage _____ 71


THE FOLLOWING DATA ARE USED ON THE NATIONAL WELL SCHEDULE
 Ownership category: (C) County, (F) Federal Gov't., (M) City, (N) Corp. or Co., (P) Private, (S) State Agency, (W) Water Dist. _____ P

Method drilled: (A) Air, (B) bored, (C) cable, (D) dug, (H) driven, (I) hyd. rotary, (J) jetted, (R) rev. rotary, (T) trenching, (S) spring, _____ D

Physiographic province: _____ 73 74 Section: _____

Drainage basin: _____ 75 76 Subbasin: _____ 77 78 79 Depth to basement: _____ source of data (basement) _____ 80

Quadrangle _____
 Well no. 12-22E-3CCB

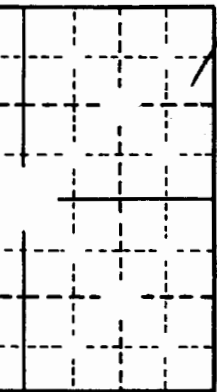

North



14

Co Road

Bridge

Kane Creek

House

Well/Barn