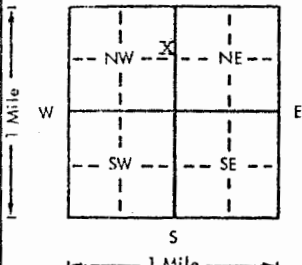


USE TYPEWRITER OR BALL
POINT PEN-PRESS FIRMLY,
PRINT CLEARLY.

WATER WELL RECORD
KSA 82a-1201-1215

Kansas Department of Health and
Environment-Division of Environment
(Water well Contractors)
Topeka, Kansas 66620

1. Location of well:	County Leavenworth	Fraction SE 1/4 NE 1/4 NW 1/4	Section number 7	Township number T 12 S R 22	Range number E/W
2. Distance and direction from nearest town or city: 2 miles NE of Street address of well location if in city: 1/4 Linwood, Kansas			3. Owner of well: Mr. Tom Miller R.R. or street: 708 So. 130th Street City, state, zip code: Bonner Springs, Kansas 66012		
4. Locate with "X" in section below: N 1 Mile W E S 1 Mile			Sketch map: 		
5. Type and color of material			From	To	6. Bore hole dia. 8 in. Completion date 9-29-77 Well depth 70 ft.
Top Soil			0	2	7. <input checked="" type="checkbox"/> Cable tool <input checked="" type="checkbox"/> Rotary <input type="checkbox"/> Driven <input type="checkbox"/> Dug <input type="checkbox"/> Hollow rod <input type="checkbox"/> Jetted <input type="checkbox"/> Bored <input type="checkbox"/> Reverse rotary
Sandstone			2	25	8. Use: <input checked="" type="checkbox"/> Domestic <input type="checkbox"/> Public supply <input type="checkbox"/> Industry <input type="checkbox"/> Irrigation <input type="checkbox"/> Air conditioning <input type="checkbox"/> Stock <input type="checkbox"/> Lawn <input type="checkbox"/> Oil field water <input type="checkbox"/> Other
Lime			25	28	9. Casing: Material Steel Height: Above or below Threaded <input type="checkbox"/> Welded <input checked="" type="checkbox"/> Surface 18 in. RMP <input type="checkbox"/> PVC <input type="checkbox"/> Weight <input type="checkbox"/> lbs./ft. Dia. 8 in. to 13 ft. depth Wall Thickness: inches or Dia. <input type="checkbox"/> in. to <input type="checkbox"/> ft. depth gage No. 10 gage
Shale			28	37	10. Screen: Manufacturer's name NONE Type <input type="checkbox"/> Dia. <input type="checkbox"/> Slot/gauze <input type="checkbox"/> Length <input type="checkbox"/> Set between <input type="checkbox"/> ft. and <input type="checkbox"/> ft. Gravel pack? None Size range of material <input type="checkbox"/>
Lime			37	63	11. Static water level: 19 ft. below land surface Date 9-29-77 mo./day/yr.
Shale			63	68	12. Pumping level below land surfaces: <input type="checkbox"/> ft. after <input type="checkbox"/> hrs. pumping <input type="checkbox"/> g.p.m. <input type="checkbox"/> ft. after <input type="checkbox"/> hrs. pumping <input type="checkbox"/> g.p.m. Estimated maximum yield 10 g.p.m.
Lime			68	70	13. Water sample submitted: <input type="checkbox"/> Yes <input checked="" type="checkbox"/> No Date <input type="checkbox"/>
					14. Well head completion: <input checked="" type="checkbox"/> Riffless adapter 18 Inches above grade
					15. Well grouted? Yes With: <input checked="" type="checkbox"/> Neat cement <input type="checkbox"/> Bentonite <input type="checkbox"/> Concrete Depth: From 3 ft. to 10 ft.
					16. Nearest source of possible contamination: ft. 150 Direction SE Type septic Well disinfected upon completion? <input checked="" type="checkbox"/> Yes <input type="checkbox"/> No
					17. Pump: Manufacturer's name Jacuzzi Model number 5343 HP 1/2 Volts 220 Length of drop pipe 25 ft. capacity 10 g.p.m. Type: <input checked="" type="checkbox"/> Submersible <input type="checkbox"/> Turbine <input type="checkbox"/> Jet <input type="checkbox"/> Reciprocating <input type="checkbox"/> Centrifugal <input type="checkbox"/> Other
(Use a second sheet if needed)					
18. Elevation: Topography: <input type="checkbox"/> Hill <input type="checkbox"/> Slope <input type="checkbox"/> Upland <input type="checkbox"/> Valley	19. Remarks: 1 gallon before shot. 10 gallons after shot. Approx. 600 gallons storage		20. Water well contractor's certification: This well was drilled under my jurisdiction and this report is true to the best of my knowledge and belief. BREUER, INC. 174 145 Business name Box 147 Basehor, Ks. 66007 Address Signed [Signature] Date 10-3-77		