

SE 1/4
N 2 E 2 SE 1/4

KANSAS WELL SCHEDULE

Card 1

Not using

Record by Klein Schmidt Date: 4-23-73 Project: Top-KC State: Kans County: Leaw 52

Latitude: _____ deg min sec Longitude: _____ deg min sec Accuracy: _____ Owner's well no: _____

Location: _____ SE no. 10 12 N., R. 22 E. Well number: 1222E10D

Owner: Raymond Hanna name address

Owner: RAYMOND HANNA Altitude: _____ Accuracy: _____

Driller: Breuer Drilling Date drilled: _____

Topography, well site: (D) _____ (F) _____ (L) _____ (R) _____ (S) _____ (T) _____ (U) _____ Spring; or depth of well: 23.3 23.3 1

Diameter: _____ inches or feet _____ Depth cased: _____ Spring, or Csg. type: 5 Finish: _____ Lift & power: Hand pump 3

Pump setting: _____ feet _____ Use of well: Domestic stock, irrigation, industrial, public supply, observation, none, test _____

Water level: 6.0 above lsd 60 M 1 4-23 D73 Water level records avail. _____

Description MP: top casing 0.5 above above lsd

Yield: _____ gpm _____ Pumping period: _____ hours or days _____ Specific capacity: _____ gpm/ft. dd _____

Pumpage and other data available: _____

Card 2

Coefficient trans: _____ gpd/ft _____ Coefficient storage: _____ Coefficient perm.: _____ gpd/ft².

Aquifer, system or series _____

Aquifer, units _____

Aquifer, thickness: _____ feet _____ Aquifer, length of well open to: _____ feet _____ Aquifer, depth to top of: _____ feet _____ Aquifer, origin: _____

Aquifer, lithology of: _____

Bedrock, system: _____ Bedrock, formation: _____ Bedrock, depth to: _____ feet _____

Surficial material: _____ lithology _____ infiltration characteristics _____ Log data avail: _____

Quality of water data available: _____ Temperature of water: _____ °F. _____ Date sampled: _____

Coefficient of leakage: _____




THE FOLLOWING DATA ARE USED ON THE NATIONAL WELL SCHEDULE
Ownership category: (C) _____ (F) _____ (M) _____ (N) _____ (P) _____ (S) _____ (W) _____

Method drilled: (A) _____ (B) _____ (C) _____ (D) _____ (V) _____ (H) _____ (J) _____ (R) _____ (T) _____ (S) _____

Physiographic province: _____ Section: _____

Drainage basin: _____ Subbasin: _____ Depth to basement: _____ source of data (basement) _____

Quadrangle _____
Well no. 12-22E-10 D

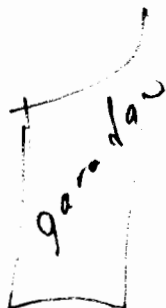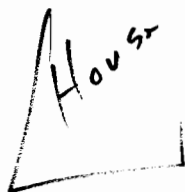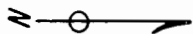

Highway